

**WATER WELL PLUGGING RECORD Form WWC-5P KSA 82a-1212 ID NO.**


1 **LOCATION OF WATER WELL:** Fraction 1/4 NE 1/4 NW 1/4 NW 1/4 Section Number 19 Township Number T 18 S Range Number 28  E  W  
 County: Lane

Street/Rural Address of Well Location; if unknown, distance & direction from nearest town or intersection: If at owner's address, check here  239 E. Long, Dighton, KS 67839

**Global Positioning Systems (GPS) information:**  
 Latitude: \_\_\_\_\_ (in decimal degrees)  
 Longitude: \_\_\_\_\_ (in decimal degrees)  
 Elevation: \_\_\_\_\_  
 Horizontal Datum:  WGS84,  NAD83,  NAD27  
 Collection Method:

2 **WATER WELL OWNER:** Farmers Coop  
 RR#, St. Address, Box #: c/o Brent Merz, P.O. Box 838  
 City, State ZIP Code: Garden City, KS 67846

GPS unit (Make/Model): \_\_\_\_\_  
 Digital Map/Photo,  Topographic Map,  Land Survey  
 Est. Accuracy:  <3 m,  3-5 m,  5-15 m,  >15 m

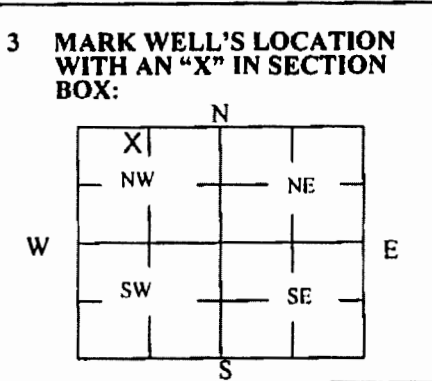

4 **DEPTH OF WELL** 62.1 ft.  
**WELL'S STATIC WATER LEVEL** 55.90 ft  
**WELL WAS USED AS:**  
 Domestic  Public Water Supply  Dewatering  
 Irrigation  Oil Field Water Supply  Monitoring MW-8  
 Feedlot  Domestic (Lawn & Garden)  Injection Well  
 Industrial  Air Conditioning  Other \_\_\_\_\_  
 Was a chemical/bacteriological sample submitted to Department? Yes  No

5 **TYPE OF BLANK CASING USED:**  
 Steel  RMP (SR)  Wrought  Fiberglass  Other (Specify below)  
 PVC  ABS  Asbestos-Cement  Concrete Tile  
 Blank casing diameter 2 in. Was casing pulled? Yes  No  If yes, how much 3'  
 Casing height above or below land surface 36 in.

6 **GROUT PLUG MATERIAL:**  Neat cement  Cement grout  Bentonite  Other \_\_\_\_\_  
 Grout Plug Intervals: From 3 ft. to 62.1 ft., From \_\_\_\_\_ ft. to \_\_\_\_\_ ft., From \_\_\_\_\_ ft. to \_\_\_\_\_ ft.  
 What is the nearest source of possible contamination:  
 Septic tank  Seepage pit  Fuel storage  Other (specify below)  
 Sewer lines  Pit privy  Fertilizer storage  
 Watertight sewer lines  Sewage lagoon  Insecticide storage  
 Lateral lines  Feedyard  Abandoned water well Direction from well? \_\_\_\_\_  
 Cess pool  Livestock pens  Oil well/Gas well How many feet? \_\_\_\_\_

FROM	TO	PLUGGING MATERIALS	FROM	TO	PLUGGING MATERIALS
0	3	Native soil			
3	62.1	Bentonite			

7 **CONTRACTOR'S OR LANDOWNER'S CERTIFICATION:** This water well was plugged under my jurisdiction and was completed on (mo/day/year) 7-7-16 and this record is true to the best of my knowledge and belief. Kansas Water Well Contractor's License No. 735. This Water Well Record was completed on (mo/day/year) 7-21-16 under the business name of MILCO Environmental Services, Inc. by (signature) [Signature]

Send one white copy to Kansas Department of Health & Environment, Geology Section, 1000 SW Jackson Street, Ste. 420, Topeka, KS 66612-1367. Send one copy to WATER WELL OWNER and retain one for your records.  
 Visit us at <http://www.kdheks.gov/waterwell/index.html> Telephone 785-296-5524.



**MILCO**

**Environmental Services, Inc.**

320 West 4th Street  
Colby, KS 67701  
Tel: 785-460-1956  
Fax: 785-460-4220  
www.milcoinc.com

July 21, 2016

Kansas Department of Health and Environment  
Bureau of Water - GWTS  
1000 SW Jackson St, Ste 420  
Topeka, KS 66612-1367

RE: Farmers Coop Elevator Station  
Dighton, Kansas  
KDHE Project Code U1-051-12966  
MILCO Project No: M271-P1-02

Dear Sir or Madam:

Please find enclosed one (1) Water Well Plugging Record for the Farmers Coop Elevator Station site in Dighton. The well was abandoned by MILCO on July 7, 2016.

If you need any additional information, please don't hesitate to contact us.

Respectfully submitted,  
**MILCO Environmental Services, Inc.**



Kathy Wheelbarger

Enclosures

RECEIVED  
JUL 26 2016  
BUREAU OF WATER