

**WATER WELL PLUGGING RECORD Form WWC-5P KSA 82a-1212 ID NO.**

VEW-2

**1 LOCATION OF WATER WELL:** Fraction 1/4 SE 1/4 SW 1/4 SW 1/4 Section Number 18 Township Number T 18 S Range Number 28  E  W


Street/Rural Address of Well Location; if unknown, distance & direction from nearest town or intersection: If at owner's address, check here  239 East Long Street

**Global Positioning Systems (GPS) information:**  
 Latitude: 38.482528 (in decimal degrees)  
 Longitude: 100.464361 (in decimal degrees)  
 Elevation: \_\_\_\_\_  
 Horizontal Datum:  WGS84,  NAD83,  NAD27  
 Collection Method: \_\_\_\_\_

**2 WATER WELL OWNER:** Farmer's Coop  
 RR#, St. Address, Box #: P.O. Box 456  
 City, State ZIP Code: Dighton, KS, 67601

GPS unit (Make/Model: \_\_\_\_\_)  
 Digital Map/Photo,  Topographic Map,  Land Survey  
 Est. Accuracy:  < 3 m,  3-5 m,  5-15 m,  > 15 m

**3 MARK WELL'S LOCATION WITH AN "X" IN SECTION BOX:**

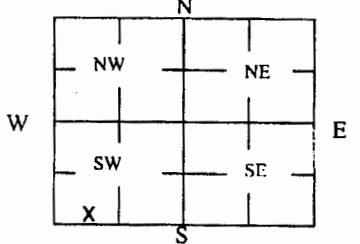

**4 DEPTH OF WELL** 20.40 ft.

WELL'S STATIC WATER LEVEL DRY ft

- WELL WAS USED AS:
- Domestic
  - Irrigation
  - Feedlot
  - Industrial
  - Public Water Supply
  - Oil Field Water Supply
  - Domestic (Lawn & Garden)
  - Air Conditioning
  - Dewatering
  - Monitoring
  - Injection Well
  - Other Vapor Extraction

Was a chemical/bacteriological sample submitted to Department? Yes  No

**5 TYPE OF BLANK CASING USED:**

- Steel
- RMP (SR)
- Wrought
- Fiberglass
- Other (Specify below) \_\_\_\_\_
- PVC
- ABS
- Asbestos-Cement
- Concrete Tile

Blank casing diameter 4 in. Was casing pulled? Yes  No  If yes, how much 3'  
 Casing height above or below land surface -36 in.

**6 GROUT PLUG MATERIAL:**  Neat cement  Cement grout  Bentonite  Other \_\_\_\_\_

Grout Plug Intervals: From 3 ft. to 20.40 ft., From \_\_\_\_\_ ft. to \_\_\_\_\_ ft., From \_\_\_\_\_ ft. to \_\_\_\_\_ ft.

- What is the nearest source of possible contamination:
- Septic tank
  - Sewer lines
  - Watertight sewer lines
  - Lateral lines
  - Cess pool
  - Seepage pit
  - Pit privy
  - Sewage lagoon
  - Feedyard
  - Livestock pens
  - Fuel storage
  - Fertilizer storage
  - Insecticide storage
  - Abandoned water well
  - Oil well/Gas well
  - Other (specify below) \_\_\_\_\_
- Direction from well? \_\_\_\_\_  
 How many feet? \_\_\_\_\_

FROM	TO	PLUGGING MATERIALS	FROM	TO	PLUGGING MATERIALS
0	0.5	Concrete			
0.5	3	Native Soil			
3	20.40	Bentonite Grout			

**7 CONTRACTOR'S OR LANDOWNER'S CERTIFICATION:** This water well was plugged under my jurisdiction and was completed on (mo/day/year) 12/6/2018 and this record is true to the best of my knowledge and belief. Kansas Water Well Contractor's License No. 881. This Water Well Record was completed on (mo/day/year) 1/8/2019 under the business name of Woofter Pump & Well by (signature) [Signature]

Send one white copy to Kansas Department of Health & Environment, Geology Section, 1000 SW Jackson Street, Ste. 420, Topcka, KS 66612-1367. Send one copy to WATER WELL OWNER and retain one for your records.  
 Visit us at <http://www.kdheks.gov/waterwell/index.html> Telephone 785-296-5524.