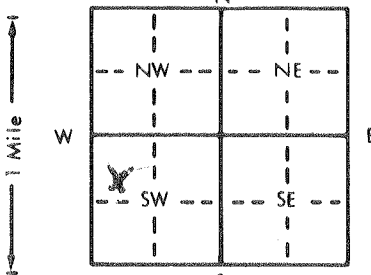


1 LOCATION OF WATER WELL: County: LANE Fraction: SW 1/4 NW 1/4 SW 1/4 Section Number: 18 Township Number: T 18 S Range Number: R 28 NW

Distance and direction from nearest town or city street address of well if located within city?
400 BLK OF N. DELAWARE, DIGHTON, KS

2 WATER WELL OWNER: CITY OF DIGHTON
 RR#, St. Address, Box #: BOX 848 Board of Agriculture, Division of Water Resources
 City, State, ZIP Code: DIGHTON, KS. 67839 Application Number: UNKNOWN

3 LOCATE WELL'S LOCATION WITH AN "X" IN SECTION BOX:

 4 DEPTH OF COMPLETED WELL: unk ft. ELEVATION: unk
 Depth(s) Groundwater Encountered: unk ft. 2. unk ft. 3. unk ft.
 WELL'S STATIC WATER LEVEL: unk ft. below land surface measured on mo/day/yr
 Pump test data: Well water was unk ft. after unk hours pumping unk gpm
 Est. Yield unk gpm: Well water was unk ft. after unk hours pumping unk gpm
 Bore Hole Diameter: unk in. to unk ft., and unk in. to unk ft.
 WELL WATER TO BE USED AS:
 1 Domestic 3 Feedlot 6 Oil field water supply 9 Dewatering 12 Other (Specify below)
 2 Irrigation 4 Industrial 7 Lawn and garden only 10 Monitoring well
 Was a chemical/bacteriological sample submitted to Department? Yes unk No unk; If yes, mo/day/yr sample was submitted unk
 Water Well Disinfected? Yes unk No unk

5 TYPE OF BLANK CASING USED:
 1 Steel 3 RMP (SR) 5 Wrought iron 8 Concrete tile CASING JOINTS: Glued unk Clamped unk
 2 PVC 4 ABS 6 Asbestos-Cement 9 Other (specify below) Welded unk
 7 Fiberglass 10 Asbestos-cement Threaded unk
 Blank casing diameter: unk in. to unk ft., Dia unk in. to unk ft., Dia unk in. to unk ft.
 Casing height above land surface: unk in., weight unk lbs./ft. Wall thickness or gauge No. unk
 TYPE OF SCREEN OR PERFORATION MATERIAL: unk
 1 Steel 3 Stainless steel 5 Fiberglass 7 PVC 10 Asbestos-cement unk
 2 Brass 4 Galvanized steel 6 Concrete tile 8 RMP (SR) 11 Other (specify) unk
 12 None used (open hole)
 SCREEN OR PERFORATION OPENINGS ARE: unk
 1 Continuous slot 3 Mill slot 5 Gauzed wrapped 8 Saw cut 11 None (open hole)
 2 Louvered shutter 4 Key punched 6 Wire wrapped 9 Drilled holes 12 None used (open hole)
 7 Torch cut 10 Other (specify) unk
 SCREEN-PERFORATED INTERVALS: From unk ft. to unk ft., From unk ft. to unk ft.
 GRAVEL PACK INTERVALS: From unk ft. to unk ft., From unk ft. to unk ft.

6 GROUT MATERIAL: 1 Neat cement 2 Cement grout 3 Bentonite 4 Other
 Grout Intervals: From unk ft. to unk ft., From unk ft. to unk ft., From unk ft. to unk ft.
 What is the nearest source of possible contamination:
 1 Septic tank 4 Lateral lines 7 Pit privy 10 Livestock pens 14 Abandoned water well
 2 Sewer lines 5 Cess pool 8 Sewage lagoon 11 Fuel storage 15 Oil well/Gas well
 3 Watertight sewer lines 6 Seepage pit 9 Feedyard 12 Fertilizer storage 16 Other (specify below)
 Direction from well? unk How many feet? unk

FROM	TO	LITHOLOGIC LOG	FROM	TO	PLUGGING INTERVALS
		<u>PLUGGED ABANDONED WELL</u>			
		<u>Bowls Fell To Bottom</u>	<u>unk</u>	<u>61'</u>	<u>ADDED 110Z HTM GL</u>
			<u>61'</u>	<u>7'</u>	<u>WASHED SAND</u>
			<u>7'</u>	<u>3'</u>	<u>ADDED 80Z HTM CL</u>
			<u>3'</u>	<u>0'</u>	<u>CEMENT</u>
					<u>BENTONITE</u>
					<u>TOP SOIL</u>

7 CONTRACTOR'S OR LANDOWNER'S CERTIFICATION: This water well was (1) constructed, (2) reconstructed, or (3) plugged under my jurisdiction and was completed on (mo/day/year) 9-1-94 and this record is true to the best of my knowledge and belief. Kansas Water Well Contractor's License No. unk This Water Well Record was completed on (mo/day/yr) 9-1-94 under the business name of CITY OF DIGHTON by (signature) [Signature]