

CORRECTION(S) TO WATER WELL RECORD (WWC-5)
(to rectify lacking or incorrect information)

County: Lane

Location listed as:

Section-Township-Range: 14-19-29 E

Fraction (1/4 1/4 1/4): NW NW NW

Location changed to:

35-18.5-29 W

NW NW NW NW

Other changes: Initial statements: Latitude: 38.25.27 N, Longitude: 100.29.4 W

Changed to: Latitude: 38° 27' 10" N., Longitude: 100° 30' 10" W., NAD 83

Comments: From Dighton: 2 mi. S., 2 mi. W., in NW corner of section, S. of road near inter-section (E-W road is good, N-S road is just a trail).

verification method: Phone call to well contractor, written description, and mapping tool & aerial photos on KGS website.

initials: APK date: 6/6/2012

submitted by: Kansas Geological Survey, Data Resources Library, 1930 Constant Ave., Lawrence, KS 66047-3726
to: Kansas Dept of Health & Environment, Bureau of Water, 1000 SW Jackson, Suite 420, Topeka, KS 66612-1367.

WATER WELL PLUGGING RECORD Form WWC-5P

KSA 82a-1212


ID NO.

1 LOCATION OF WATER WELL: County: <u>Lane</u>	Fraction: <u>NW¹/₄ NW¹/₄ NW¹/₄</u>	Section Number: <u>14</u>	Township Number: <u>19</u>	Range Number: <u>29</u> (E/W)
---	--	---------------------------	----------------------------	-------------------------------

Distance and direction from nearest town or city street address of well if located within city?

2mi South of Dighton + 2 miles West

2 WATER WELL OWNER: <u>Robert Paris</u> RR#, St. Address, Box #: <u>HC2 Box 320</u> City, State ZIP Code: <u>Dighton, Ks 67839</u>	Global Positioning Systems (decimal degrees, min. of 4 digits) Latitude: <u>38.25.27 N</u> Longitude: <u>100.29.4 W</u> Elevation: <u>2815</u> Datum: _____ Data Collection Method: <u>GPS</u>
---	--

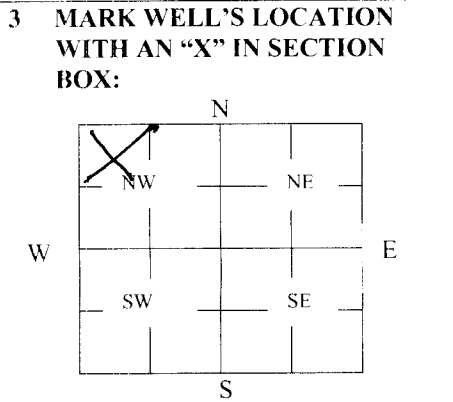

4 DEPTH OF WELL 54 ft.
WELL'S STATIC WATER LEVEL 24 ft.
WELL WAS USED AS:

<input checked="" type="checkbox"/> Domestic	5 Public Water Supply	9 Dewatering
2 Irrigation	6 Oil Field Water Supply	10 Monitoring
3 Feedlot	7 Domestic (Lawn & Garden)	11 Injection Well
4 Industrial	8 Air Conditioning	12 Other _____

Was a chemical/bacteriological sample submitted to Department? Yes _____ No X

5 TYPE OF BLANK CASING USED:

<input checked="" type="checkbox"/> 1 Steel	3 RMP (SR)	5 Wrought	7 Fiberglass	9 Other (Specify below) _____
2 PVC	4 ABS	6 Asbestos-Cement	8 Concrete Tile	_____

Blank casing diameter 6 in. Was casing pulled? Yes X No _____ If yes, how much 6ft
 Casing height above or below land surface 6 in.

6 GROUT PLUG MATERIAL: 1 Neat cement 2 Cement grout 3 Bentonite 4 Other _____

Grout Plug Intervals: From 6 ft. to 3 ft., From _____ ft. to _____ ft., From _____ to _____ ft.

What is the nearest source of possible contamination:

1 Septic tank	6 Seepage pit	11 Fuel Storage	16 Other (specify below) _____
2 Sewer lines	7 Pit privy	12 Fertilizer storage	_____
3 Watertight sewer lines	8 Sewage lagoon	13 Insecticide storage	_____
4 Lateral lines	9 Feedyard	14 Abandoned water well	Direction from well? <u>North</u>
5 Cess pool	10 Livestock pens	<u>15 Oil well/Gas well</u>	How many feet? <u>1000</u>

FROM	TO	PLUGGING MATERIALS	FROM	TO	PLUGGING MATERIALS
<u>54</u>	<u>24</u>	<u>Sand</u>			
<u>24</u>	<u>6</u>	<u>Soil</u>			
<u>6</u>	<u>3</u>	<u>Cement grout</u>			
<u>3</u>	<u>0</u>	<u>Soil</u>			

7 CONTRACTOR'S OR LANDOWNER'S CERTIFICATION: This water well was plugged under my jurisdiction and was completed on (mo/day/year) 9-20-11 and this record is true to the best of my knowledge and belief. Kansas Water Well Contractor's License No. 827. This Water Well Record was completed on (mo/day/year) 10-12-11 under the business name of Evel Windmill Repair by (signature) David L. Evel

INSTRUCTIONS: Use typewriter or ballpoint pen. Please press firmly and print clearly. Please fill in blanks, underline or circle the correct answers. Send top three copies to Kansas Department of Health and Environment, Bureau of Water, Geology Section, 1000 SW Jackson St., Ste. 420, Topeka, Kansas 66612-1367. Telephone: 785/296-5522. Send one to Water Well Owner and retain one for your records. Visit us at <http://www.kdheks.gov/geo/waterwells>.