**WATER WELL PLUGGING RECORD** **Form WWC-5P** **KSA 82a-1212** **ID NO.** **MW10**

| 1 LOCATION OF WATER WELL: County: Lane | Fraction ¼ SW ¼ SW ¼ SE ¼ | Section Number 13 | Township Number T 18 S | Range Number 29 [ ] E [X] W |
|---|---|---|---|---|

Street/Rural Address of Well Location; if unknown, distance & direction from nearest town or intersection: If at owner's address, check here [ ]

740 West Long St., Dighton, KS

**Global Positioning Systems (GPS) information:**
Latitude: NA (in decimal degrees)
Longitude: NA (in decimal degrees)
Elevation: NA
Horizontal Datum [ ] WGS84, [ ] NAD83, [ ] NAD27
Collection Method:
[ ] GPS unit (Make/model: ____)
[ ] Digital Map/Photo, [ ] Topographic Map [ ] Land Survey
Est. Accuracy: [ ] <3 m, [ ] 3-5 m, [ ] 5-15 m, [ ] >15 m

**2 WATER WELL OWNER:** Chevron Env. Management Co.
RR#, St. Address, Box #: 4800 Fownaee Place, PO Box 430
City, State ZIP Code: Bellaire, TX

**3 MARK WELL'S LOCATION WITH AN "X" IN SECTION BOX:**

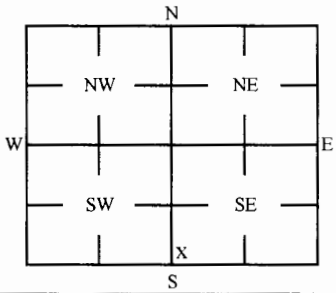


**4 DEPTH OF WELL** 64.09 **ft.**

WELL'S STATIC WATER LEVEL NA ft

WELL WAS USED AS:

[ ] Domestic [ ] Public Water Supply [ ] Dewatering
[ ] Irrigation [ ] Oil Field Water Supply [X] Monitoring
[ ] Feedlot [ ] Domestic (Lawn & Garden) [ ] Injetion Well
[ ] Industrial [ ] Air Conditioning [ ] Other ____

Was a chemical/bacteriological sample submitted to Department? Yes [ ] No [X]

**5 TYPE OF BLANK CASING USED:**

[ ] Steel [ ] RMP (SR) [ ] Wrought [ ] Fiberglass [ ] Other (Specific below)
[X] PVC [ ] ABS [ ] Asbestos-Cement [ ] Concrete Tile

Blank casing diameter ____ in. Was casing pulled? Yes [X] No [ ] If yes, how much ____
Casing heigh above or below land surface NA in.

**6 GROUT PLUG MATERIAL:** [ ] Neat cement [ ] Cement grout [X] Bentonite [X] Other Grass/topsoil: 0-0.5

Grout Plug Intervals: From 0.5 ft to 64.09 ft, From ____ ft to ____ ft, From ____ ft to ____ ft,

What is the nearest source of possible contamination:

[ ] Septic tank [ ] Seepage pit [ ] Fuel storage [ ] Other (specify below)
[ ] Sewer lines [ ] Pit privy [ ] Fertilizer storage
[ ] Watertight sewer lines [ ] Sewage lagoon [ ] Insecticide storage
[ ] Lateral lines [ ] Feed yard [ ] Abandoned water well Direction from well? ____
[ ] Cess pool [ ] Livestock pens [ ] Oil well/Gas well How many feet? ____

| FROM | TO | PLUGGING MATERIALS | FROM | TO | PLUGGING MATERIALS |
|---|---|---|---|---|---|
| 0 | 0.5 | Grass/topsoil | | | |
| 0.5 | 64.09 | Bentonite | | | |
| | | | | | |
| | | | | | |
| | | | | | |
| | | | KDHE ID: Former Chevron #302545; U1-051-13027 | | |
| | | | | | |
| | | | | | |

**7 CONTRACTOR'S OR LANDOWNER'S CERTIFICATION:** This water well was plugged ~~under my jurisdiction~~ and was completed on (mo/day/year) 6/11/2018 and this record is true to the best of my ~~knowledge and belief.~~ Kansas Water Contractor's License No. 757 . This Water Well Record was completed on (mo/day/year) ~~6/19/2018~~ ~~under the~~ business name of Larsen & Associates, Inc. By (signature) ____

Send one white copy to Kansas Department of Health & Environment, Geology Section, 1000 SW Jackson Street, Ste. 420, Topeka, KS 66612-1367. Send one copy to WATER WELL OWNER and retain one for your records
Visit us at http://www.kdheks.gov/waterwell/index.html Telephone 785-296-5524.