


1 LOCATION OF WATER WELL: County: McPherson Fraction: NE 1/4 NW 1/4 Section Number: 4 Township Number: T 18 S Range Number: R 3 E/W

Distance and direction from nearest town or city street address of well if located within city?  
3 mi. South & 1/2 mi. East of Lindsborg, KS

2 WATER WELL OWNER: ~~Glenn S. Wallace~~ John A. Taylor  
 RR#, St. Address, Box #: ~~209 E~~ P.O. Box 783  
 City, State, ZIP Code: McPherson, KS 67460 Board of Agriculture, Division of Water Resources Application Number:

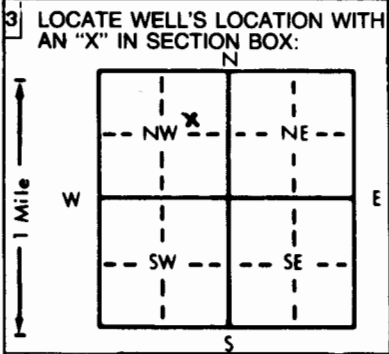

4 DEPTH OF COMPLETED WELL: 260 ft. ELEVATION:  
 Depth(s) Groundwater Encountered 1. 24 ft. 2. \_\_\_\_\_ ft. 3. \_\_\_\_\_ ft.  
 WELL'S STATIC WATER LEVEL: 40 ft. below land surface measured on mo/day/yr 5/15/97  
 Pump test data: Well water was 180 ft. after 2 hours pumping 10 gpm  
 Est. Yield 10 gpm: Well water was \_\_\_\_\_ ft. after \_\_\_\_\_ hours pumping \_\_\_\_\_ gpm  
 Bore Hole Diameter: 12 in. to 45 ft., and 8 in. to 260 ft.  
 WELL WATER TO BE USED AS:  
 1 Domestic  3 Feedlot  6 Oil field water supply  9 Dewatering  12 Other (Specify below)  
 2 Irrigation  4 Industrial  7 Lawn and garden only  10 Monitoring well  
 Was a chemical/bacteriological sample submitted to Department? Yes \_\_\_\_\_ No  If yes, mo/day/yr sample was submitted \_\_\_\_\_  
 Water Well Disinfected?  Yes  No

5 TYPE OF BLANK CASING USED:  
 1 Steel  3 RMP (SR)  5 Wrought iron  8 Concrete tile CASING JOINTS:  Glued  Clamped  
 2 PVC  4 ABS  6 Asbestos-Cement  9 Other (specify below)  Welded  
 Blank casing diameter 5 in. to 260 ft., Dia \_\_\_\_\_ in. to \_\_\_\_\_ ft., Dia \_\_\_\_\_ in. to \_\_\_\_\_ ft.  
 Casing height above land surface: 24 in., weight \_\_\_\_\_ lbs./ft. Wall thickness or gauge No. Schedule 40  
 Threaded

TYPE OF SCREEN OR PERFORATION MATERIAL:  
 1 Steel  3 Stainless steel  5 Fiberglass  7 PVC  10 Asbestos-cement  
 2 Brass  4 Galvanized steel  6 Concrete tile  9 ABS  11 Other (specify) \_\_\_\_\_  
 12 None used (open hole)

SCREEN OR PERFORATION OPENINGS ARE:  
 1 Continuous slot  3 Mill slot  5 Gauzed wrapped  8 Saw cut  11 None (open hole)  
 2 Louvered shutter  4 Key punched  6 Wire wrapped  9 Drilled holes  
 7 Torch cut  10 Other (specify) \_\_\_\_\_

SCREEN-PERFORATED INTERVALS: From 80 ft. to 100 ft., From 180 ft. to 260 ft.  
 From 160 ft. to 180 ft., From \_\_\_\_\_ ft. to \_\_\_\_\_ ft.  
 GRAVEL PACK INTERVALS: From 70 ft. to 260 ft., From \_\_\_\_\_ ft. to \_\_\_\_\_ ft.  
 From \_\_\_\_\_ ft. to \_\_\_\_\_ ft., From \_\_\_\_\_ ft. to \_\_\_\_\_ ft.

6 GROUT MATERIAL:  1 Neat cement  2 Cement grout  3 Bentonite  4 Other \_\_\_\_\_  
 Grout Intervals: From 30 ft. to 70 ft., From surface ft. to 30 ft., From \_\_\_\_\_ ft. to \_\_\_\_\_ ft.  
 What is the nearest source of possible contamination:  
 1 Septic tank  4 Lateral lines  7 Pit privy  10 Livestock pens  14 Abandoned water well  
 2 Sewer lines  5 Cess pool  8 Sewage lagoon  11 Fuel storage  15 Oil well/Gas well  
 3 Watertight sewer lines  6 Seepage pit  9 Feedyard  12 Fertilizer storage  16 Other (specify below) \_\_\_\_\_  
 13 Insecticide storage  
 Direction from well? North How many feet? 200

FROM	TO	LITHOLOGIC LOG	FROM	TO	PLUGGING INTERVALS
0	4	Hardpan			
4	45	Clay-tan			
45	148	Shale			
148	169	Sandy Shale			
169	192	Shale			
192	193	Hard Sand			
193	213	Grey Shale			
213	217	Sandy Shale			
217	247	Grey Shale			
247	252	Sandy Shale			
252	256	Grey Shale			
256	260	Sandy Shale			

7 CONTRACTOR'S OR LANDOWNER'S CERTIFICATION: This water well was  (1) constructed  (2) reconstructed, or  (3) plugged under my jurisdiction and was completed on (mo/day/year) 5/15/97 and this record is true to the best of my knowledge and belief. Kansas Water Well Contractor's License No. 610-A This Water Well Record was completed on (mo/day/yr) 6/2/97 under the business name of None by (signature) Glenn S. Wallace