


WATER WELL RECORD Form WWC-5 KSA 82a-1212

1 LOCATION OF WATER WELL:	Fraction	Section Number	Township Number	Range Number
County: McPherson	NE 1/4 NE 1/4 NW 1/4	22	T 18 S	R 3 EW

Distance and direction from nearest town or city street address of well if located within city?

7 Miles North of McPherson

2 WATER WELL OWNER: Jay & Sarah Bremeyer	Board of Agriculture, Division of Water Resources
RR#, St. Address, Box #: 1500 Pueblo Road	Application Number:
City, State, ZIP Code: McPherson, KS 67460	

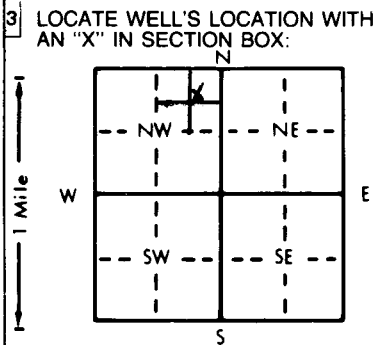

4 DEPTH OF COMPLETED WELL: 50 ft.	ELEVATION:
Depth(s) Groundwater Encountered: 1. 34.0 ft. 2. ft. 3. ft.	
WELL'S STATIC WATER LEVEL: 22.2 ft. below land surface measured on mo/day/yr 11/10/97	
Pump test data: Well water was ft. after hours pumping gpm	
Est. Yield gpm: Well water was ft. after hours pumping gpm	
Bore Hole Diameter: 6 in. to 60 ft., and in. to ft.	
WELL WATER TO BE USED AS:	
5 Public water supply 8 Air conditioning 11 Injection well	
1 Domestic 3 Feedlot 6 Oil field water supply 9 Dewatering 12 Other (Specify below)	
2 Irrigation 4 Industrial 7 Lawn and garden only 10 Monitoring well	
Was a chemical/bacteriological sample submitted to Department? Yes No X; If yes, mo/day/yr sample was submitted	
Water Well Disinfected? Yes No	

5 TYPE OF BLANK CASING USED:	5 Wrought iron	8 Concrete tile	CASING JOINTS: Glued Clamped
1 Steel	3 RMP (SR)	6 Asbestos-Cement	9 Other (specify below)
2 PVC	4 ABS	7 Fiberglass	Welded
Blank casing diameter: 2 in. to 30 ft., Dia in. to ft., Dia in. to ft.			Threaded
Casing height above land surface: -5 in., weight lbs./ft. Wall thickness or gauge No. Sch. 40			
TYPE OF SCREEN OR PERFORATION MATERIAL:	7 PVC	10 Asbestos-cement	
1 Steel	3 Stainless steel	5 Fiberglass	8 RMP (SR)
2 Brass	4 Galvanized steel	6 Concrete tile	9 ABS
11 Other (specify)			
12 None used (open hole)			
SCREEN OR PERFORATION OPENINGS ARE:	5 Gauzed wrapped	8 Saw cut	11 None (open hole)
1 Continuous slot	3 Mill slot	6 Wire wrapped	9 Drilled holes
2 Louvered shutter	4 Key punched	7 Torch cut	10 Other (specify) Factory Cut
SCREEN-PERFORATED INTERVALS: From 50 ft. to 30 ft., From ft. to ft.			
GRAVEL PACK INTERVALS: From 60 ft. to 28 ft., From ft. to ft.			

6 GROUT MATERIAL:	1 Neat cement	2 Cement grout	3 Bentonite	4 Other
Grout Intervals: 3 From 28 ft. to 26 ft. 2 From 26 ft. to 0 ft., From ft. to ft.				
What is the nearest source of possible contamination:				
1 Septic tank	4 Lateral lines	7 Pit privy	10 Livestock pens	14 Abandoned water well
2 Sewer lines	5 Cess pool	8 Sewage lagoon	11 Fuel storage	15 Oil well/Gas well
3 Watertight sewer lines	6 Seepage pit	9 Feedyard	12 Fertilizer storage	16 Other (specify below)
			13 Insecticide storage	See Attachment

FROM	TO	LITHOLOGIC LOG	FROM	TO	PLUGGING INTERVALS
0	1	Topsoil			
1	32	Gray Till			
32	60	Br. Clay w/ Some Sand Streaks			

7 CONTRACTOR'S OR LANDOWNER'S CERTIFICATION: This water well was (1) constructed, (2) reconstructed, or (3) plugged under my jurisdiction and was completed on (mo/day/year) 10/24/97 and this record is true to the best of my knowledge and belief. Kansas Water Well Contractor's License No. 542 This Water Well Record was completed on (mo/day/yr) 11/24/97 under the business name of T.D. Drilling by (signature) *Anneth Meyer*

INSTRUCTIONS: Use typewriter or ball point pen. PLEASE PRESS FIRMLY and PRINT clearly. Please fill in blanks, underline or circle the correct answers. Send top three copies to Kansas Department of Health and Environment, Bureau of Water, Topeka, Kansas 66620-0001. Telephone: 913-296-5545. Send one to WATER WELL OWNER and retain one for your records.