


WATER WELL RECORD Form WWC-5 KSA 82a-1212

1 LOCATION OF WATER WELL: Fraction $\frac{1}{4}$ NE $\frac{1}{4}$ NW $\frac{1}{4}$ Section Number 22 Township Number T 18 Range Number R 3
 County: McPherson Distance and direction from nearest town or city street address of well if located within city?

7 Miles North of McPherson

2 WATER WELL OWNER: Jay & Sarah Bremeyer
 RR#, St. Address, Box #: 1500 ~~Paeblo~~ Road Board of Agriculture, Division of Water Resources
 City, State, ZIP Code: McPherson, KS Application Number Well # MW-510

3 LOCATE WELL'S LOCATION WITH AN "X" IN SECTION BOX:

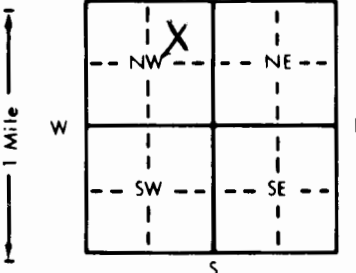

4 DEPTH OF COMPLETED WELL: 50 ft. ELEVATION:
 Depth(s) Groundwater Encountered 1. 35.3 ft. 2. ft. 3. ft.
 WELL'S STATIC WATER LEVEL 35.3 ft. below land surface measured on mo/day/yr
 Pump test data: Well water was ft. after hours pumping gpm
 Est. Yield gpm: Well water was ft. after hours pumping gpm
 Bore Hole Diameter 5 in. to ft., and in. to ft.
 WELL WATER TO BE USED AS: 5 Public water supply 8 Air conditioning 11 Injection well
 1 Domestic 3 Feedlot 6 Oil field water supply 9 Dewatering 12 Other (Specify below)
 2 Irrigation 4 Industrial 7 Lawn and garden only 10 Monitoring well
 Was a chemical/bacteriological sample submitted to Department? Yes No If yes, mo/day/yr sample was submitted

5 TYPE OF BLANK CASING USED: 5 Wrought iron 8 Concrete tile CASING JOINTS: Glued Clamped
 1 Steel 3 RMP (SR) 6 Asbestos-Cement 9 Other (specify below) Welded
 2 PVC 4 ABS 7 Fiberglass Threaded

Blank casing diameter 2 in. to ft., Dia in. to ft., Dia in. to ft.
 Casing height above land surface in., weight lbs./ft. Wall thickness or gauge No. Schedule 40

TYPE OF SCREEN OR PERFORATION MATERIAL: 7 PVC 10 Asbestos-cement
 1 Steel 3 Stainless steel 8 RMP (SR) 11 Other (specify) 12 None used (open hole)
 2 Brass 4 Galvanized steel 6 Concrete tile 9 ABS

SCREEN OR PERFORATION OPENINGS ARE: 5 Gauzed wrapped 8 Saw cut 11 None (open hole)
 1 Continuous slot 3 Mill slot 6 Wire wrapped 9 Drilled holes
 2 Louvered shutter 4 Key punched 7 Torch cut 10 Other (specify) Factory Cut

SCREEN-PERFORATED INTERVALS: From 50 ft. to 35 ft., From ft. to ft.
 GRAVEL PACK INTERVALS: From 55 ft. to 33 ft., From ft. to ft.

6 GROUT MATERIAL: 1 Neat cement 2 Cement grout 3 Bentonite 4 Other Concrete
 Grout Intervals 3 From 33 ft. to 31 ft. 2 From 31 ft. to 1.5 ft. 4 From 1.5 ft. to 0 ft.

What is the nearest source of possible contamination:
 1 Septic tank 4 Lateral lines 7 Pit privy 10 Livestock pens 14 Abandoned water well
 2 Sewer lines 5 Cess pool 8 Sewage lagoon 11 Fuel storage 15 Oil well/Gas well
 3 Watertight sewer lines 6 Seepage pit 9 Feedyard 12 Fertilizer storage 16 Other (specify below)
 13 Insecticide storage See Attached

Direction from well? How many feet?

FROM	TO	LITHOLOGIC LOG	FROM	TO	PLUGGING INTERVALS
0	5	Sand & Gravel			
5	10	F-M Sand & Silt w/ Gravel			
10	25	Br. Hard Silt & Clay w/ Gravel			
25	45	Reddish Hard Silt & Clay			
45	60	Br. Soft Silty Clay			
60	105	Very Hard Br. Silt & Clay			
105	115	Green Clay	55	130	Bentonite Chips
115	125	Gray Clay very hard			
130	130	Red Clay & Bedrock			
130		EOP			
		Well Set 50.0			

7 CONTRACTOR'S OR LANDOWNER'S CERTIFICATION: This water well was 1 constructed, 2 reconstructed, or 3 plugged under my jurisdiction and was completed on (mo/day/year) 7/29/95 and this record is true to the best of my knowledge and belief. Kansas Water Well Contractor's License No. 452 This Water Well Record was completed on (mo/day/yr) 9/30/97 under the business name of T.D. Drilling Inc. by (signature) Kenneth Meyer