

1 LOCATION OF WATER WELL: County: McPherson Fraction: SE 1/4 SE 1/4 NW 1/4 Section Number: 32 Township Number: T 18 S Range Number: R 3 E/W

Distance and direction from nearest town or city street address of well if located within city? 4 1/2 miles North of McPherson, KS (HLSBOG)

2 WATER WELL OWNER: U.S. Dept of Agriculture Farm Service Agency
RR#, St. Address, Box # P.O. Box 2415, SOUTH Agriculture Bldg Board of Agriculture, Division of Water Resources
City, State, ZIP Code: Washington, D.C. 20013 Application Number:

3 LOCATE WELL'S LOCATION WITH AN "X" IN SECTION BOX:

4 DEPTH OF COMPLETED WELL: 205 ft. ELEVATION:

Depth(s) Groundwater Encountered 1. ft. 2. ft. 3. ft.

WELL'S STATIC WATER LEVEL 77.27 ft. below land surface measured on mo/day/yr 4/25/97

Pump test data: Well water was ft. after hours pumping gpm
Est. Yield 15 gpm: Well water was Developed 2 1/2 hours pumping ± 15 gpm
Bore Hole Diameter: 9 3/8 in. to ft., and in. to ft.

WELL WATER TO BE USED AS: 5 Public water supply 8 Air conditioning 11 Injection well
1 Domestic 3 Feedlot 6 Oil field water supply 9 Dewatering 12 Other (Specify below)
2 Irrigation 4 Industrial 7 Lawn and garden only 10 Monitoring well

Was a chemical/bacteriological sample submitted to Department? Yes No X If yes, mo/day/yr sample was submitted

Water Well Disinfected? Yes No X

5 TYPE OF BLANK CASING USED: 1 Steel 3 RMP (SR) 5 Wrought iron 8 Concrete tile CASING JOINTS: Glued Clamped
2 PVC 4 ABS 6 Asbestos-Cement 9 Other (specify below) Welded
Blank casing diameter 4 in. to 109-114 ft. Dia. 4" in. to 0-99' ft. Dia. in. to ft.
Casing height above land surface 6 in., weight lbs./ft. Wall thickness or gauge No. See 40 PVC

TYPE OF SCREEN OR PERFORATION MATERIAL: 1 Steel 3 Stainless steel 5 Fiberglass 7 PVC 10 Asbestos-cement
2 Brass 4 Galvanized steel 6 Concrete tile 8 RMP (SR) 11 Other (specify)
SCREEN OR PERFORATION OPENINGS ARE: 5 Gauzed wrapped 8 Saw cut 11 None (open hole)
1 Continuous slot 610 3 Mill slot 6 Wire wrapped 9 Drilled holes
2 Louvered shutter 4 Key punched 7 Torch cut 10 Other (specify)

SCREEN-PERFORATED INTERVALS: From 99 ft. to 109 ft. From ft. to ft.
From 7 ft. to ft. From ft. to ft.
GRAVEL PACK INTERVALS: From 115.5 ft. to 95.5 ft. From ft. to ft.
From ft. to ft. From ft. to ft.

6 GROUT MATERIAL: 1 Neat cement 2 Cement grout 3 Bentonite 4 Other Bentonite seals 91-95, 114.5-118

Grout Intervals: From 99 ft. to surface ft. From ft. to ft. From ft. to ft.


What is the nearest source of possible contamination: 1 Septic tank 4 Lateral lines 7 Pit privy 10 Livestock pens 14 Abandoned water well
2 Sewer lines 5 Cess pool 8 Sewage lagoon 11 Fuel storage 15 Oil well/Gas well
3 Watertight sewer lines 6 Seepage pit 9 Feedyard 12 Fertilizer storage 16 Other (specify below)
13 Insecticide storage


Direction from well? How many feet?

FROM	TO	LITHOLOGIC LOG	FROM	TO	PLUGGING INTERVALS
See enclosed Lithology					

7 CONTRACTOR'S OR LANDOWNER'S CERTIFICATION: This water well was (1) constructed, (2) reconstructed, or (3) plugged under my jurisdiction and was completed on (mo/day/year) 4-30-97 and this record is true to the best of my knowledge and belief. Kansas
Water Well Contractor's License No. 581 This Water Well Record was completed on (mo/day/yr) 5-28-97
under the business name of Layne Western Co by (signature) Steven R. Matney

Argonne National Laboratory			Soil Boring ID: SB06	
			Log Type: Soil Boring	
Project: HILTON	Ground Elevation: 0	Total Depth: 205 FT	Driller: Name	
			Company: Company	
Date: 4/13/97	Plot Date: 5/5/97	Geologist: name	Rig: Rig	
Depth (feet)	LITHOLOGY		Well Construction	
			Description	Casing Annular Material Description

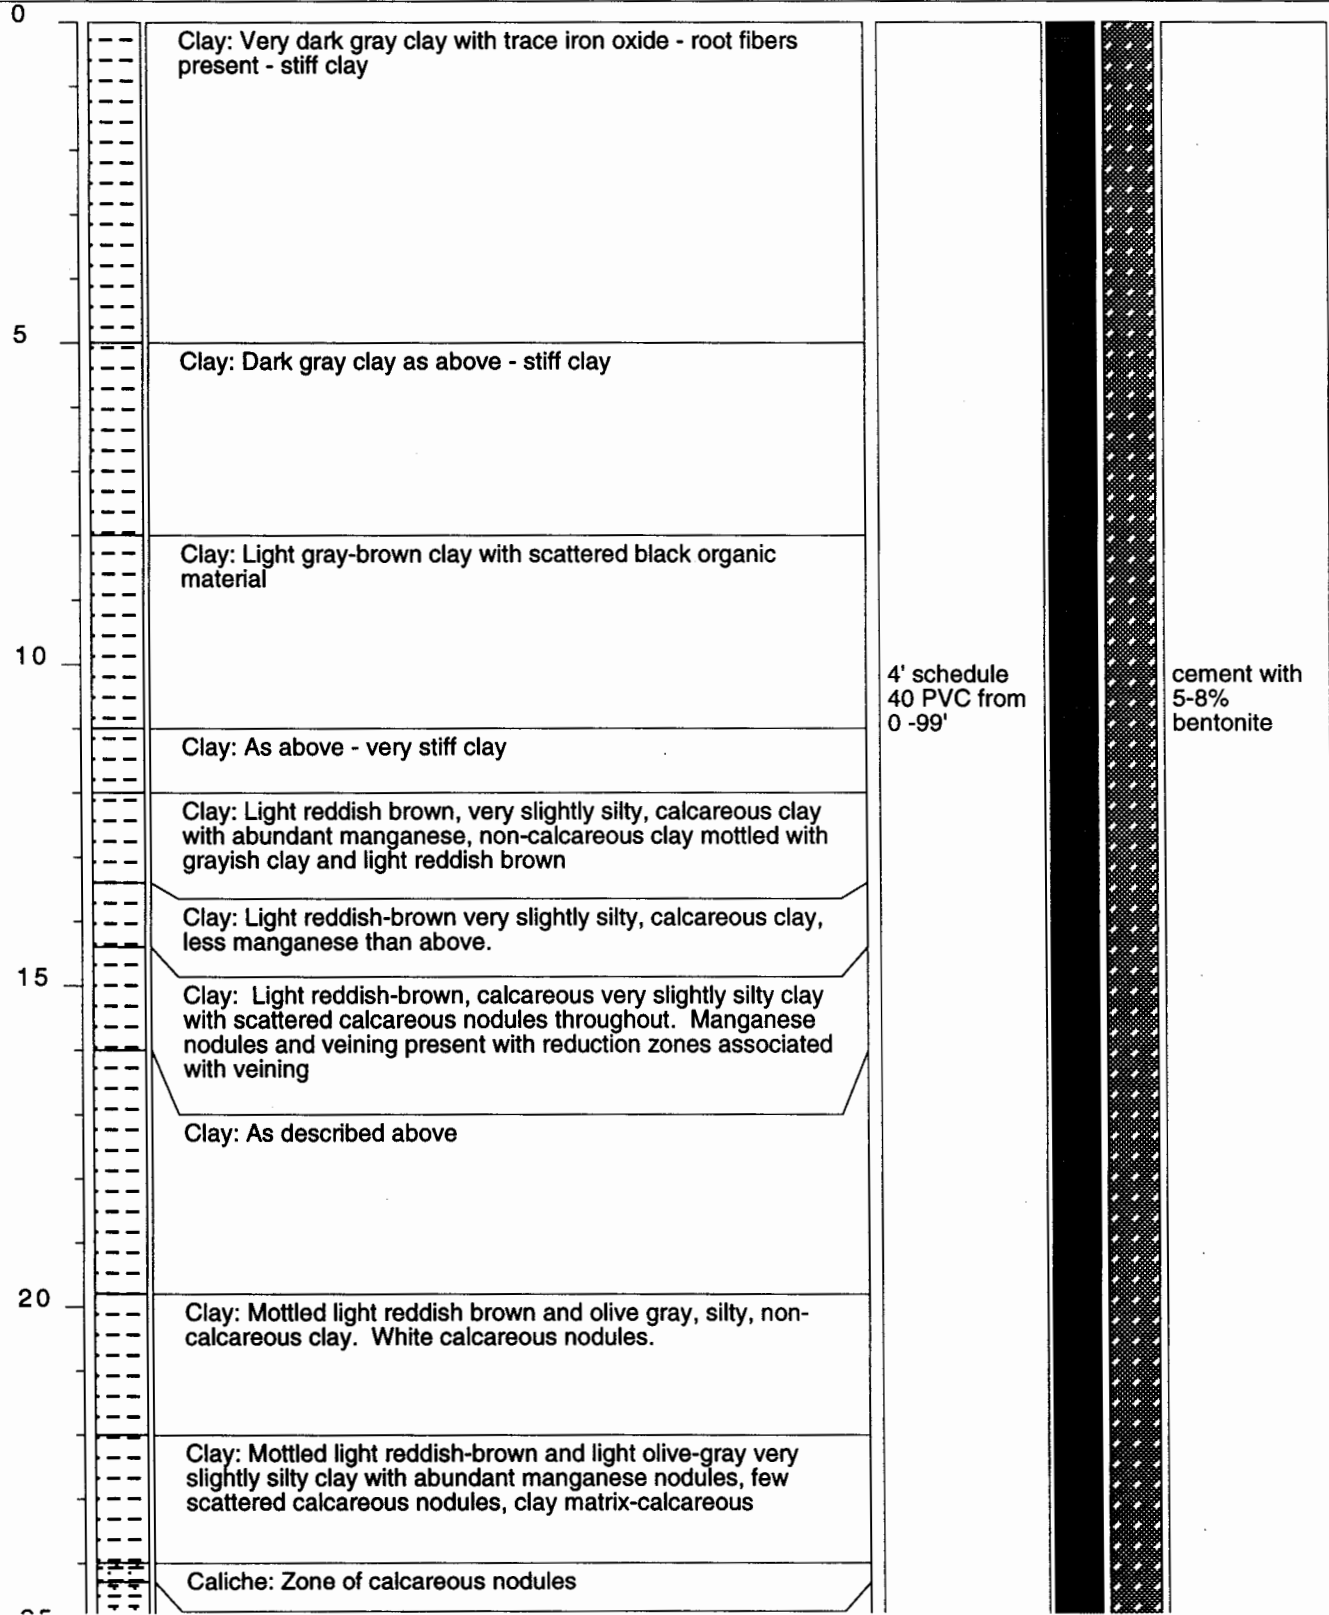

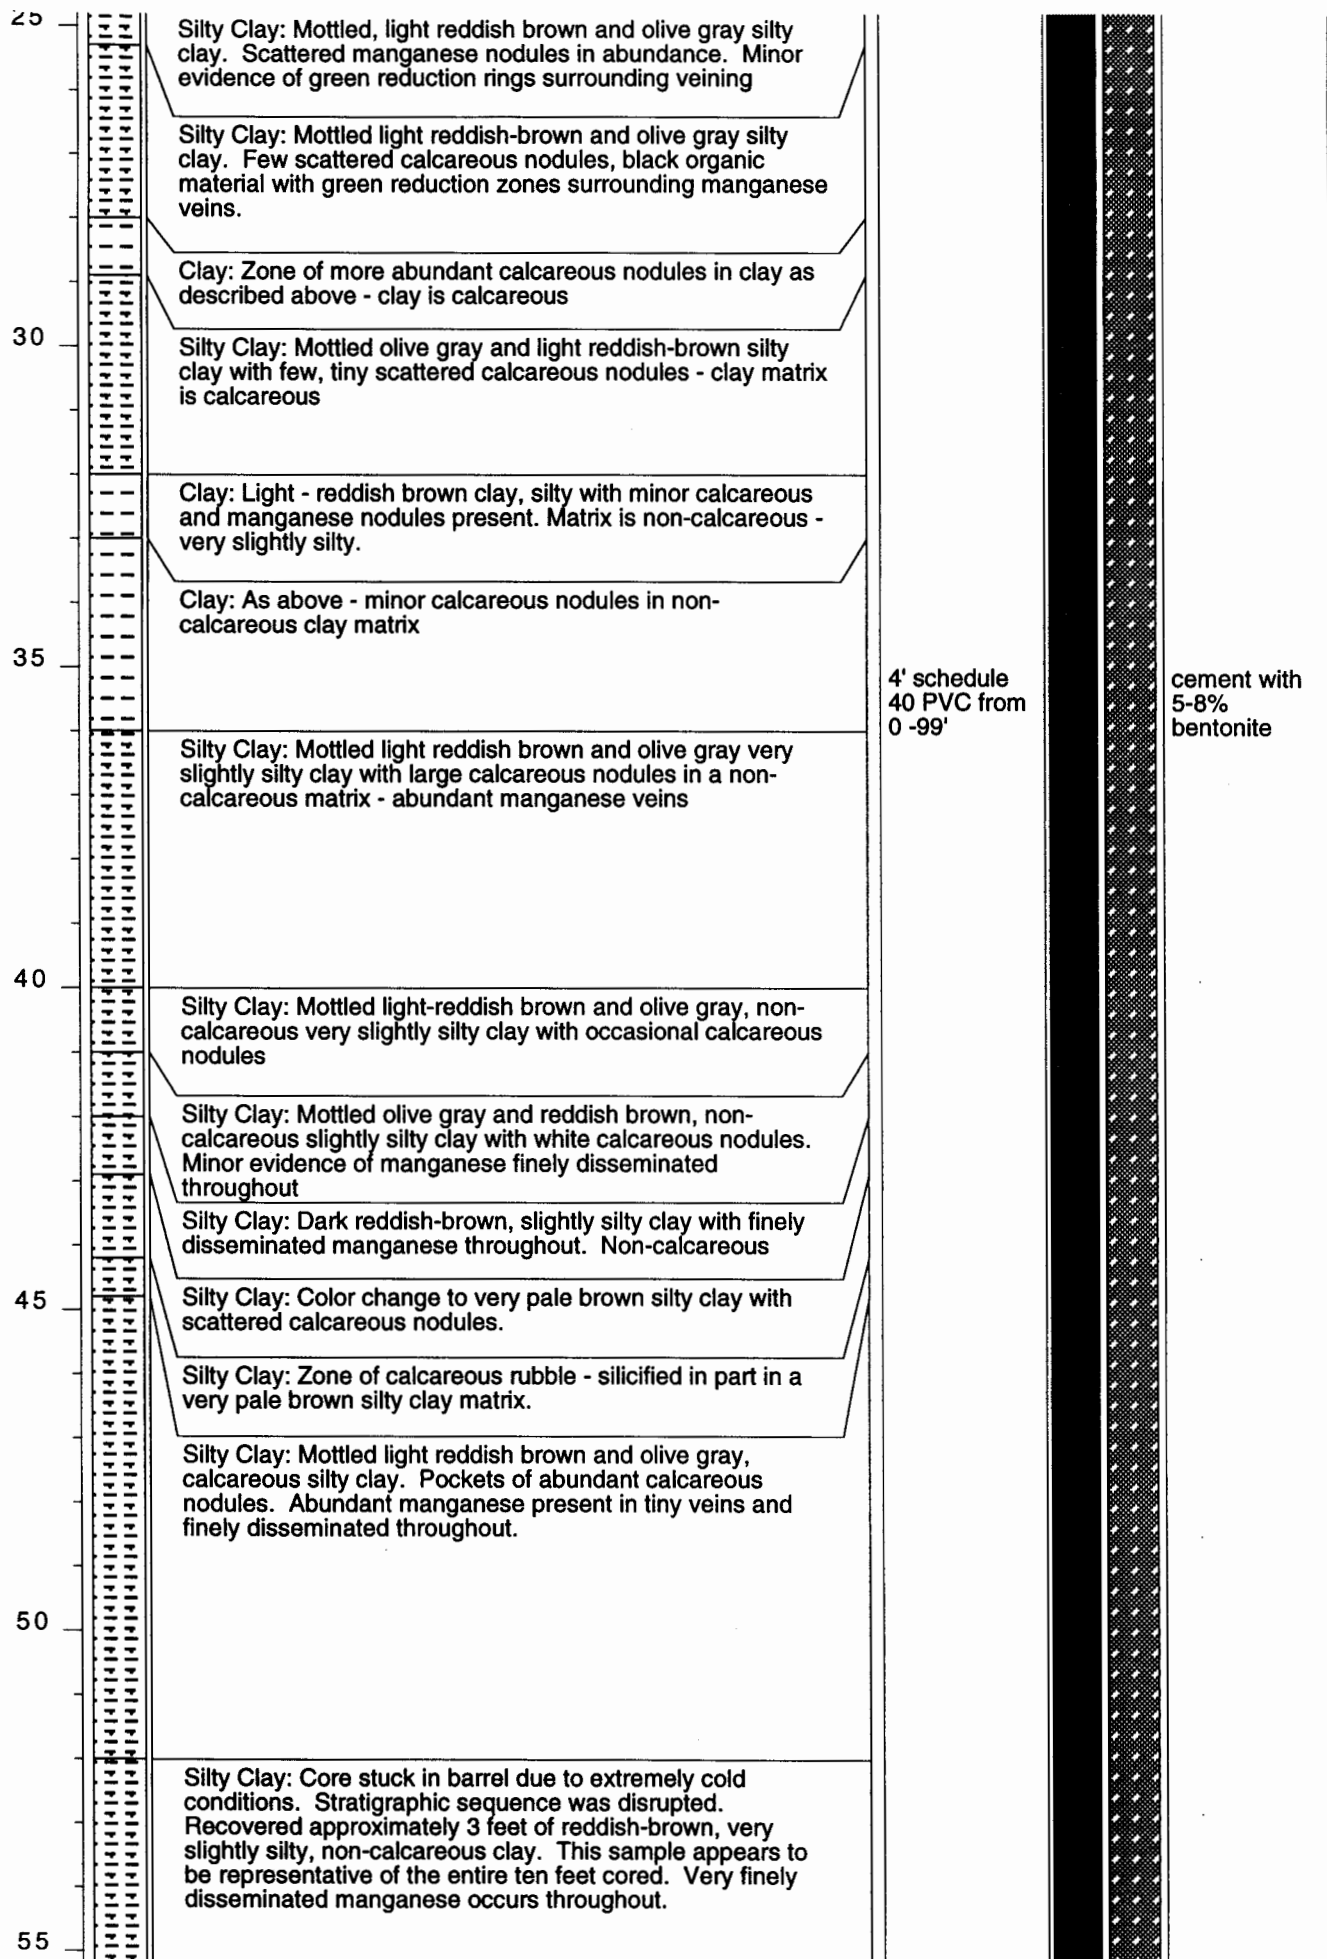

60

Silty Clay: Brown slightly silty clay, non-calcareous, trace of finely disseminated managnese at top increasing to abundant at base of unit

65

Caliche: 2" nodular (calcareous) zone in clay as described above

Caliche: Light reddish brown, very slightly silty, highly calcareous throughout

Clay: Rubble zone - siliceous clays in nodules (3 inches). Calcareous matrix as above.

Clay: Light reddish brown clay - very slightly silty. Calcareous as above. Finely disseminated managnese throughout.

70

Clay: Rubble zone - 2 inches - silicified clay decreasing amount of calcium carbonate in section. Finely disseminated manganese throughout.

silty clay: Light reddish-brown silty clay/minor calcium carbonate nodules present in non-calcareous matrix. Finely disseminated manganese throughout.

Clay: 1" rubble zone, silicified clay - very slightly silty/finely disseminated manganese throughout

75

Silty Clay: Light reddish brown very slightly silty clay with intermittent zones of silicified clay, and calcium carbonate nodules present in calcareous matrix. Finely disseminated manganese throughout

Clay: Zone of silicified clay clasts with manganese nodules, calcareous. Very slightly silty clay matrix.

Silty Clay: Light reddish brown very slightly silty clay - non-calcareous/finely disseminated manganese throughout.

80

Silty Clay: Red very slightly silty clay - note color change. Manganese present with trace calcareous shell fragments (pelecypod). Slightly calcareous matrix. Finely disseminated manganese throughout.


Silty Clay: Zone of white calcareous nodules in a silty red clay (caliche). Finely disseminated manganese.


Silty Clay: Red with manganese present as tiny nodules and finely disseminated material throughout. Tiny calcareous nodules also scattered throughout. Entire section becomes increasingly calcareous with depth.

85

Caliche: Zone of white calcareous rubble - nodular - caliche zone - in red silty clay matrix.

WL. 27.27'

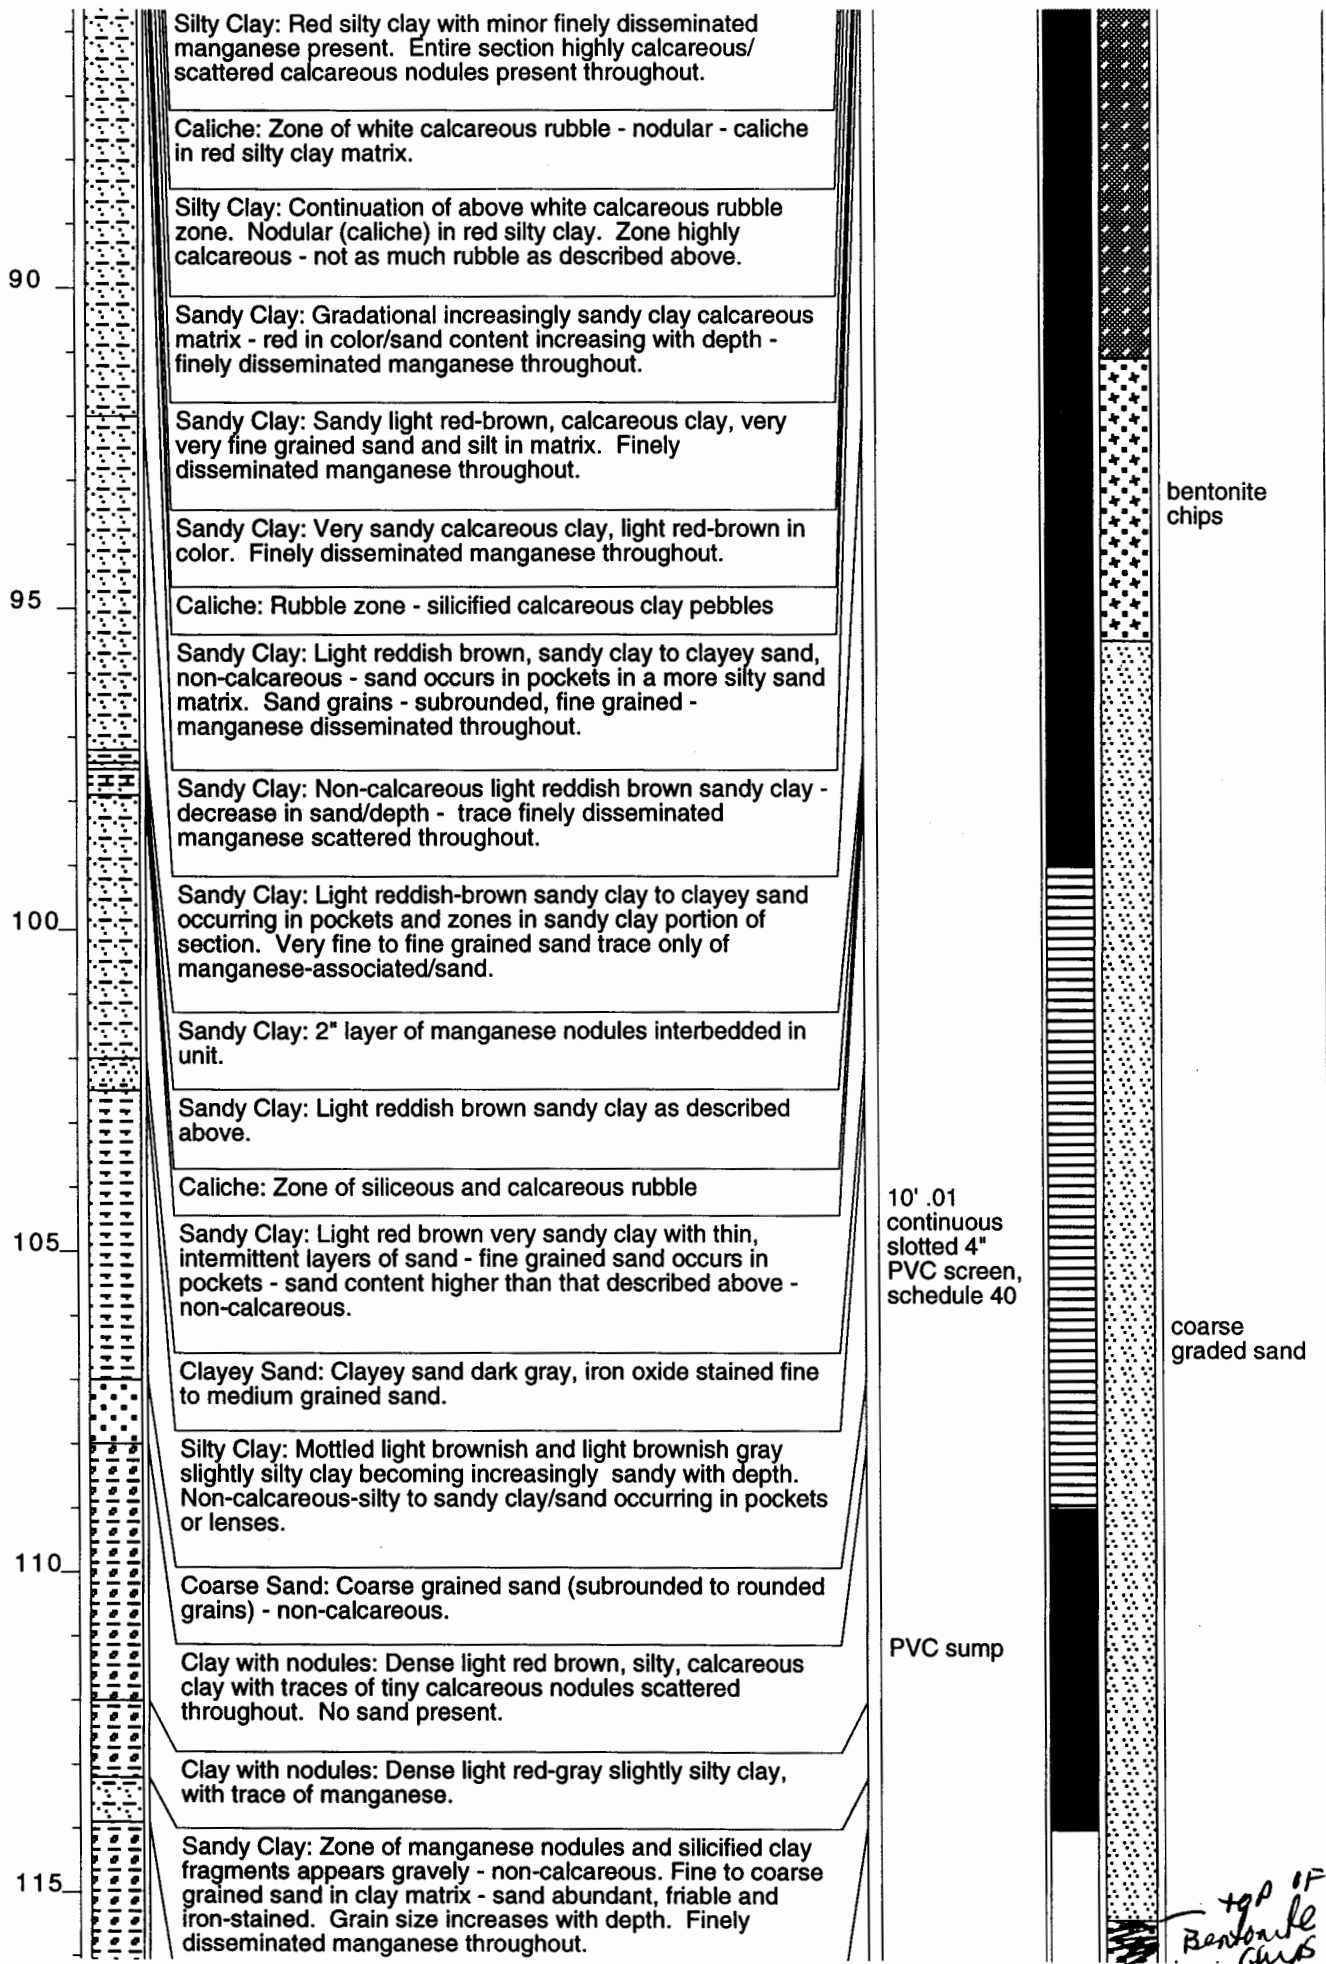

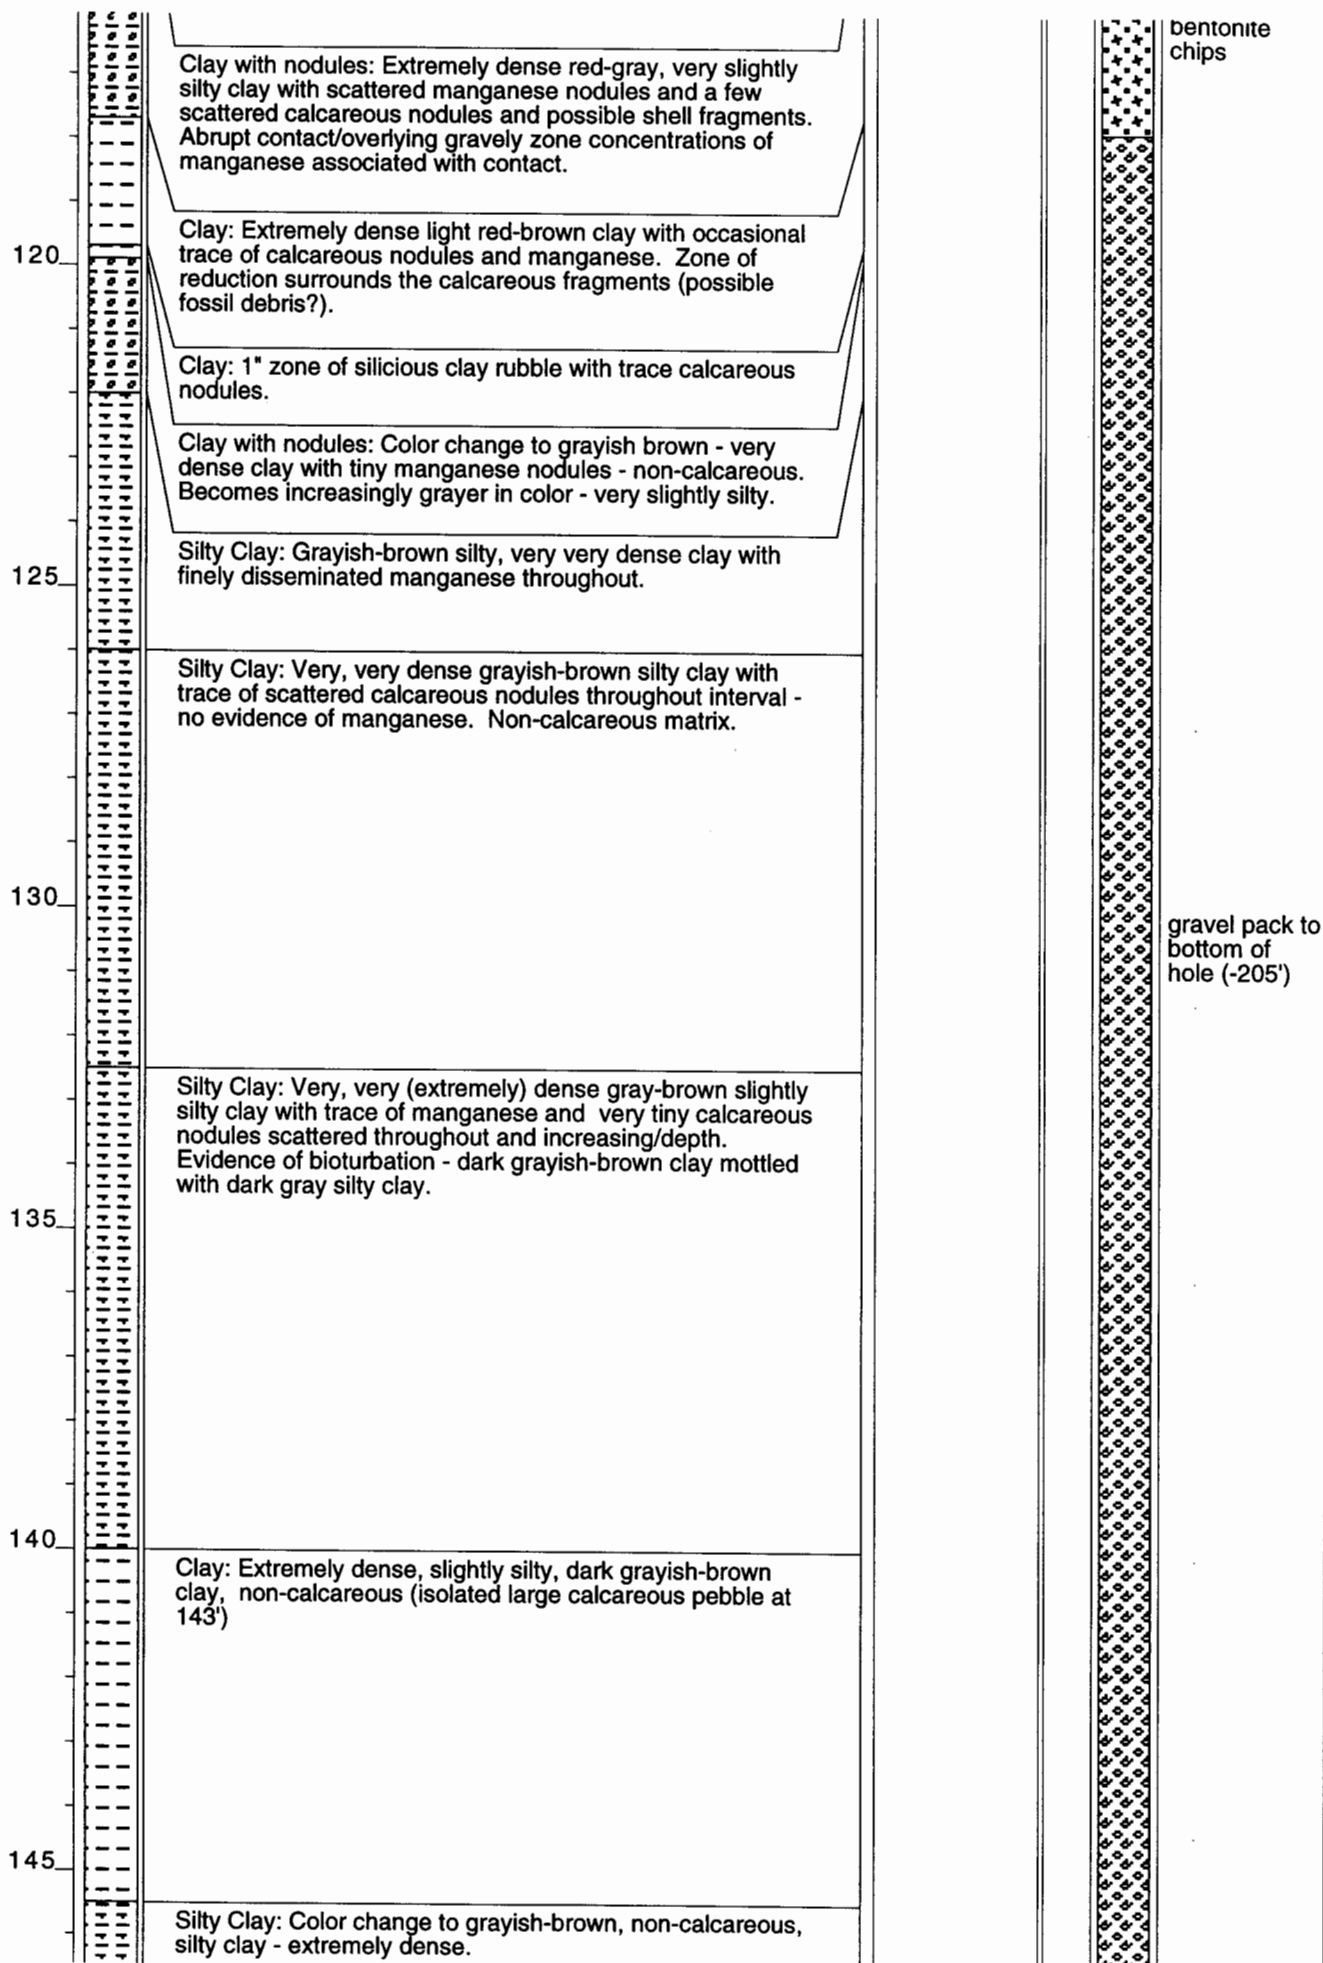

150

155

Silty Clay: Gray to grayish-brown, extremely dense, non-calcareous, silty clay. At 150'-154' - color gray. At 154' - 160' - gray-brown.

160

Silty Clay: Gray-brown, extremely dense, slightly silty, non-calcareous clay. Single calcareous nodule in interval. Evidence of bioturbation throughout with brown-gray clay being burrowed then infilled with mottled clay (dark gray) described above. At 164.5' - 167' bioturbation is really pronounced.

165

Silty Clay: Gray-brown very slightly silty clay. Bioturbated as described above with decrease in evidence of bioturbation with depth. Very, very dense clay.

170

Silty Clay: Very, very dense, very slightly silty clay, dark gray in color grading to dark grayish-brown. Evidence of bioturbation as described above/slightly silty mottled brown and light olive gray clays. Evidence of white calcium carbonate (possible shell fragment in part) and tiny nodules increasing in frequency with depth.

175

Clay: Becoming reddish-brown in color, very slightly silty, very dense clay - minor calcareous nodules.

