


1 LOCATION OF WATER WELL: County: <b>McPherson</b>	Fraction <b>SW 1/4 SE 1/4 SW 1/4</b>	Section Number <b>4</b>	Township Number <b>T 18 S</b>	Range Number <b>R 3</b>
---	---	----------------------------	----------------------------------	----------------------------

Distance and direction from nearest town or city street address of well if located within city?  
**4 Miles South of Lindsborg, KS**

2 WATER WELL OWNER: **Curtis Priddy**  
 RR#, St. Address, Box # : **R.R. 2**  
 City, State, ZIP Code : **Lindsborg, KS 67456**  
 Board of Agriculture, Division of Water Resources  
 Application Number:

3 LOCATE WELL'S LOCATION WITH AN "X" IN SECTION BOX:

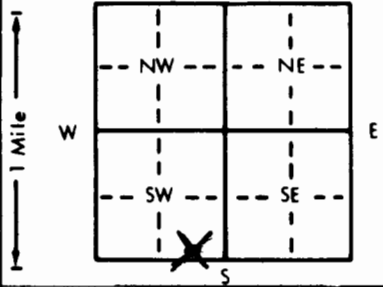

4 DEPTH OF COMPLETED WELL: **91** ft. ELEVATION:

Depth(s) Groundwater Encountered 1. **45** ft. 2. ft. 3. ft.  
 WELL'S STATIC WATER LEVEL **45** ft. below land surface measured on mo/day/yr  
 Pump test data: Well water was ft. after hours pumping gpm  
 Est. Yield **6-10** gpm: Well water was ft. after hours pumping gpm  
 Bore Hole Diameter **8** in. to **91** ft. and in. to ft.  
 WELL WATER TO BE USED AS:  
 1 Domestic 3 Feedlot 6 Oil field water supply 9 Dewatering 12 Other (Specify below)  
 2 Irrigation 4 Industrial 7 Lawn and garden only 10 Monitoring well  
 Was a chemical/bacteriological sample submitted to Department? Yes  No ; If yes, mo/day/yr sample was submitted  
 Water Well Disinfected? Yes  No

5 TYPE OF BLANK CASING USED:  
 1 Steel 3 RMP (SR) 5 Wrought iron 8 Concrete tile CASING JOINTS: Glued  Clamped  
 2 PVC 4 ABS 6 Asbestos-Cement 9 Other (specify below) Welded  
 7 Fiberglass Threaded

Blank casing diameter **5** in. to **51** ft., Dia **61** in. to **81** ft., Dia in. to ft.  
 Casing height above land surface **12** in., weight **2.37** lbs./ft. Wall thickness or gauge No. **214**

TYPE OF SCREEN OR PERFORATION MATERIAL:  
 1 Steel 3 Stainless steel 5 Fiberglass 7 PVC 10 Asbestos-cement  
 2 Brass 4 Galvanized steel 6 Concrete tile 8 RMP (SR) 11 Other (specify)  
 9 ABS 12 None used (open hole)

SCREEN OR PERFORATION OPENINGS ARE:  
 1 Continuous slot 3 Mill slot 5 Gauzed wrapped 8 Saw cut 11 None (open hole)  
 2 Louvered shutter 4 Key punched 6 Wire wrapped 9 Drilled holes  
 7 Torch cut 10 Other (specify)

SCREEN-PERFORATED INTERVALS: From **51** ft. to **61** ft., From ft. to ft.  
 From **81** ft. to **91** ft., From ft. to ft.  
 GRAVEL PACK INTERVALS: From **25** ft. to **91** ft., From ft. to ft.  
 From ft. to ft., From ft. to ft.

6 GROUT MATERIAL: 1 Neat cement 2 Cement grout 3 Bentonite 4 Other  
 Grout Intervals: From **5** ft. to **25** ft., From ft. to ft., From ft. to ft.

What is the nearest source of possible contamination:  
 1 Septic tank 4 Lateral lines 7 Pit privy 10 Livestock pens 14 Abandoned water well  
 2 Sewer lines 5 Cess pool 8 Sewage lagoon 11 Fuel storage 15 Oil well/Gas well  
 3 Watertight sewer lines 6 Seepage pit 9 Feedyard 12 Fertilizer storage 16 Other (specify below)  
 13 Insecticide storage **Old Well**

Direction from well? **North East** How many feet? **70 ft**

FROM	TO	LITHOLOGIC LOG	FROM	TO	PLUGGING INTERVALS
0	3	Top Soil	89	91	Grey Shale
3	24	Tan Clay			
24	26	Creek Gravel			
26	40	Tan Clay			
40	42	Tan Clay W/creek gravel			
42	54	Tan Clay			
54	56	Tan Clay W/Creek Gravel			
56	58	Tan Clay			
58	59	Course Creek Gravel			
59	61	Tan Clay			
61	65	Tan Clay W/creek Gravel			
65	68	Red Fractured Shale (Good Fractures)			
68	70	Green Shale (some small Fractures)			
70	89	Red & Green Shale (Small Fractures)			

7 CONTRACTOR'S OR LANDOWNER'S CERTIFICATION: This water well was (1) constructed, (2) reconstructed, or (3) plugged under my jurisdiction and was completed on (mo/day/year) **6-11-91** and this record is true to the best of my knowledge and belief. Kansas Water Well Contractor's License No. **138**. This Water Well Record was completed on (mo/day/yr) **6-15-91** under the business name of **Peterson Irrigation, Inc.** by (signature) *Milo Peterson*