


1 LOCATION OF WATER WELL: County: McPherson	Fraction SE 1/4 SW 1/4 SE 1/4	Section Number 10	Township Number T 18 S	Range Number R 3
---	---	-----------------------------	----------------------------------	----------------------------

Distance and direction from nearest town or city street address of well if located within city?
5 miles South & 1 3/4 mile East of Lindsborg

2 WATER WELL OWNER: **Tim Miller**
 RR#, St. Address, Box # : **P.O. Box 611**
 City, State, ZIP Code : **Galva, KS 67443**
 Board of Agriculture, Division of Water Resources
 Application Number:

3 LOCATE WELL'S LOCATION WITH AN "X" IN SECTION BOX:

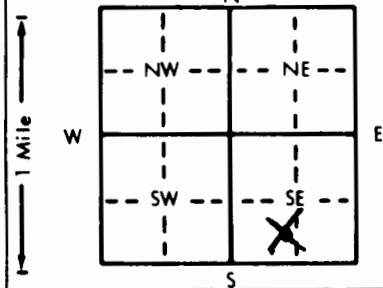

4 DEPTH OF COMPLETED WELL... **62** ft. ELEVATION:

Depth(s) Groundwater Encountered 1... **2.1** ft. 2... .. ft. 3... .. ft.

WELL'S STATIC WATER LEVEL... **2.1** ft. below land surface measured on mo/day/yr... **8-2-93**

Pump test data: Well water was ... ft. after ... hours pumping ... gpm

Est. Yield **4-5** gpm: Well water was **5.2** ft. after **1** hours pumping **5** gpm

Bore Hole Diameter: **8** in. to **6.2** ft., and ... in. to ... ft.

WELL WATER TO BE USED AS:

5 Public water supply	8 Air conditioning	11 Injection well
1 Domestic	3 Feedlot	6 Oil field water supply
2 Irrigation	4 Industrial	7 Lawn and garden only
		10 Monitoring well
		9 Dewatering
		12 Other (Specify below)

Was a chemical/bacteriological sample submitted to Department? Yes..... No ; If yes, mo/day/yr sample was submitted

Water Well Disinfected? Yes No

5 TYPE OF BLANK CASING USED:

1 Steel	3 RMP (SR)	5 Wrought iron	8 Concrete tile	CASING JOINTS: Glued <input checked="" type="checkbox"/> Clamped
2 PVC	4 ABS	6 Asbestos-Cement	9 Other (specify below)	Welded
		7 Fiberglass		Threaded

Blank casing diameter ... **5** in. to **5.2** ft., Dia. ... in. to ... ft., Dia. ... in. to ... ft.

Casing height above land surface... **1.2** in., weight **2.37** lbs./ft. Wall thickness or gauge No. **214**

TYPE OF SCREEN OR PERFORATION MATERIAL:

1 Steel	3 Stainless steel	5 Fiberglass	8 RMP (SR)	10 Asbestos-cement
2 Brass	4 Galvanized steel	6 Concrete tile	9 ABS	11 Other (specify)
				12 None used (open hole)

SCREEN OR PERFORATION OPENINGS ARE:

1 Continuous slot	3 Mill slot	5 Gauzed wrapped	8 Saw cut	11 None (open hole)
2 Louvered shutter	4 Key punched	6 Wire wrapped	9 Drilled holes	
		7 Torch cut	10 Other (specify)	

SCREEN-PERFORATED INTERVALS: From... **5.2** ft. to **6.2** ft., From ... ft. to ... ft.

GRAVEL PACK INTERVALS: From... **2.5** ft. to **6.2** ft., From ... ft. to ... ft.

6 GROUT MATERIAL: 1 Neat cement 2 Cement grout 3 Bentonite 4 Other

Grout Intervals: From... **5** ft. to **25** ft., From ... ft. to ... ft., From ... ft. to ... ft.

What is the nearest source of possible contamination: **None within 1/4 mile**

1 Septic tank	4 Lateral lines	7 Pit privy	10 Livestock pens	14 Abandoned water well
2 Sewer lines	5 Cess pool	8 Sewage lagoon	11 Fuel storage	15 Oil well/Gas well
3 Watertight sewer lines	6 Seepage pit	9 Feedyard	12 Fertilizer storage	16 Other (specify below)
			13 Insecticide storage	

Direction from well? How many feet?

FROM	TO	LITHOLOGIC LOG	FROM	TO	PLUGGING INTERVALS
0	4	Black Top Soil			
4	28	Brown Clay			
28	39	Tan Clay			
39	46	Brown Clay with layers of cemented sands			
46	53	Brown Sandy Clay			
53	59	Sandstone			
59	62	Gray Shale			

7 CONTRACTOR'S OR LANDOWNER'S CERTIFICATION: This water well was (1) constructed, (2) reconstructed, or (3) plugged under my jurisdiction and was completed on (mo/day/year) **8-2-93** and this record is true to the best of my knowledge and belief. Kansas Water Well Contractor's License No. **138** This Water Well Record was completed on (mo/day/yr), **8-10-93** under the business name of **Peterson Irrigation Inc.** by (signature) *Mike Peterson*

INSTRUCTIONS: Use typewriter or ball point pen. PLEASE PRESS FIRMLY and PRINT clearly. Please fill in blanks, underline or circle the correct answers. Send top three copies to Kansas Department of Health and Environment, Bureau of Water, Topeka, Kansas 66620-0001. Telephone: 913-296-5545. Send one to WATER WELL OWNER and retain one for your records.