


1 LOCATION OF WATER WELL:	Fraction	Section Number	Township Number	Range Number
County: <u>McPherson</u>	<u>NW</u> $\frac{1}{4}$ <u>SW</u> $\frac{1}{4}$ <u>SW</u> $\frac{1}{4}$	<u>33</u>	T <u>18</u> S	R <u>3</u> <u>SW</u>

Distance and direction from nearest town or city street address of well if located within city?

2 WATER WELL OWNER:	Board of Agriculture, Division of Water Resources
RR#, St. Address, Box # : <u>Dr. M.S. Scoby</u>	Application Number: <u>34291</u>
City, State, ZIP Code : <u>McPherson, KS. 67460</u>	

3 LOCATE WELL'S LOCATION WITH AN "X" IN SECTION BOX:	4 DEPTH OF COMPLETED WELL: <u>165</u> ft. ELEVATION:
--	--

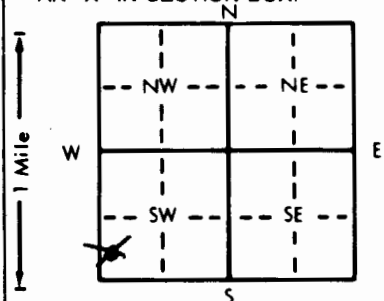

Depth(s) Groundwater Encountered	1. ft.	2. ft.	3. ft.
WELL'S STATIC WATER LEVEL	<u>103</u> ft. below land surface measured on mo/day/yr		
Pump test data:	Well water was	ft. after	hours pumping
Est. Yield	<u>400</u> gpm	Well water was	ft. after
Bore Hole Diameter	<u>30</u> in. to	ft., and	in. to
WELL WATER TO BE USED AS:	5 Public water supply	8 Air conditioning	11 Injection well
1 Domestic	3 Feedlot	6 Oil field water supply	9 Dewatering
2 Irrigation	4 Industrial	7 Lawn and garden only	10 Monitoring well
Was a chemical/bacteriological sample submitted to Department? Yes.....No..... <u>X</u> If yes, mo/day/yr sample was submitted			
Water Well Disinfected? Yes <u>X</u> No			

5 TYPE OF BLANK CASING USED:	5 Wrought iron	8 Concrete tile	CASING JOINTS: Glued	Clamped <u>X</u>
1 Steel	3 RMP (SR)	6 Asbestos-Cement	9 Other (specify below)	Welded
2 PVC	4 ABS	7 Fiberglass		Threaded
Blank casing diameter	<u>16</u> in. to	ft., Dia	in. to	ft., Dia
Casing height above land surface	<u>12</u> in., weight	lbs./ft. Wall thickness or gauge No.		
TYPE OF SCREEN OR PERFORATION MATERIAL:	5 Fiberglass	8 RMP (SR)	11 Other (specify)	
1 Steel	3 Stainless steel	6 Concrete tile	9 ABS	12 None used (open hole)
2 Brass	4 Galvanized steel			
SCREEN OR PERFORATION OPENINGS ARE:	5 Gauzed wrapped	8 Saw cut	11 None (open hole)	
1 Continuous slot	3 Mill slot	6 Wire wrapped	9 Drilled holes	
2 Louvered shutter	4 Key punched	7 Torch cut	10 Other (specify)	
SCREEN-PERFORATED INTERVALS:	From	ft. to	ft., From	ft. to
	From	ft. to	ft., From	ft. to
GRAVEL PACK INTERVALS:	From	ft. to	ft., From	ft. to
	From	ft. to	ft., From	ft. to

6 GROUT MATERIAL:	1 Neat cement	2 <u>Cement grout</u>	3 Bentonite	4 Other
Grout Intervals:	From	ft. to	ft., From	ft. to
What is the nearest source of possible contamination:	1 Septic tank	4 Lateral lines	7 Pit privy	10 Livestock pens
	2 Sewer lines	5 Cess pool	8 Sewage lagoon	11 Fuel storage
	3 Watertight sewer lines	6 Seepage pit	9 Feedyard	12 Fertilizer storage
				13 Insecticide storage
Direction from well?				How many feet?

FROM	TO	LITHOLOGIC LOG	FROM	TO	PLUGGING INTERVALS
		<u>Plugged</u>			
<u>25</u>	<u>165</u>	<u>Chlorinated Gravel Pack</u>			
<u>20</u>	<u>25</u>	<u>Bentonite grout</u>			
<u>3</u>	<u>0</u>	<u>Cement grout</u>			
		<u>Top Soil</u>			

7 CONTRACTOR'S OR LANDOWNER'S CERTIFICATION: This water well was (1) constructed, (2) reconstructed, or (3) plugged under my jurisdiction and was completed on (mo/day/year) <u>9-3-91</u> and this record is true to the best of my knowledge and belief. Kansas Water Well Contractor's License No. <u>138</u> This Water Well Record was completed on (mo/day/yr) <u>9-6-91</u> under the business name of <u>PETERSON IRRIGATION INC.</u> by (signature) <u>Mike Peterson</u>
