


1 LOCATION OF WATER WELL: County: <b>McPherson</b>	Fraction: <b>SE 1/4 SW 1/4 NW 1/4</b>	Section Number: <b>28</b>	Township Number: <b>T 18 S</b>	Range Number: <b>R 3 EW</b>
--	---------------------------------------	---------------------------	--------------------------------	-----------------------------

Distance and direction from nearest town or city street address of well if located within city?

**5 miles North of McPherson, Ks.**

2 WATER WELL OWNER: **Robert Bailey**  
 RR#, St. Address, Box # : **506 Sonora Dr.**  
 City, State, ZIP Code : **McPherson, Ks. 67460**  
 Board of Agriculture, Division of Water Resources  
 Application Number:

3 LOCATE WELL'S LOCATION WITH AN "X" IN SECTION BOX:

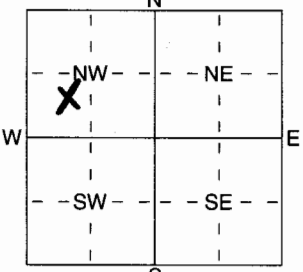

4 DEPTH OF COMPLETED WELL **123** ft. ELEVATION: ..... ft.

Depth(s) Groundwater Encountered 1 ..... ft. 2 ..... ft. 3 ..... ft.  
 WELL'S STATIC WATER LEVEL **65** ft. below land surface measured on mo/day/yr **12/14/05**  
 Pump test data: Well water was ..... ft. after ..... hours pumping ..... gpm  
 Est. Yield **30-40** gpm: Well water was ..... ft. after ..... hours pumping ..... gpm  
 WELL WATER TO BE USED AS: 5 Public water supply 8 Air conditioning 11 Injection well  
 Domestic 3 Feedlot 6 Oil field water supply 9 Dewatering 12 Other (Specify below)  
 2 Irrigation 4 Industrial 7 Domestic (lawn & garden) 10 Monitoring well

Was a chemical/bacteriological sample submitted to Department? Yes ..... No  .....; If yes, mo/day/yrs sample was submitted  
 Water Well Disinfected? Yes  No

5 TYPE OF BLANK CASING USED: 5 Wrought iron 8 Concrete tile CASING JOINTS: Glued  Clamped .....  
 1 Steel 3 RMP (SR) 6 Asbestos-Cement 9 Other (specify below) Welded .....  
 PVC 4 ABS 7 Fiberglass ..... Threaded .....

Blank casing diameter ..... **5** in. to **10.3** ft., Dia ..... in. to ..... ft., Dia ..... in. to ..... ft.  
 Casing height above land surface **12** in., weight **2.37** lbs./ft. Wall thickness or gauge No. **.214**

TYPE OF SCREEN OR PERFORATION MATERIAL:  PVC 10 Asbestos-Cement  
 1 Steel 3 Stainless Steel 5 Fiberglass 8 RMP (SR) 11 Other (Specify) .....  
 2 Brass 4 Galvanized Steel 6 Concrete tile 9 ABS 12 None used (open hole)

SCREEN OR PERFORATION OPENINGS ARE: 5 Gauzed wrapped 8 Saw cut 11 None (open hole)  
 1 Continuous slot  Mill slot 6 Wire wrapped 9 Drilled holes  
 2 Louvered shutter 4 Key punched 7 Torch cut 10 Other (specify) ..... ft.

SCREEN-PERFORATED INTERVALS: From **1.03** ft. to **1.23** ft., From ..... ft. to ..... ft.  
 From ..... ft. to ..... ft., From ..... ft. to ..... ft.  
 GRAVEL PACK INTERVALS: From **20** ft. to **1.23** ft., From ..... ft. to ..... ft.  
 From ..... ft. to ..... ft., From ..... ft. to ..... ft.

6 GROUT MATERIAL: 1 Neat cement 2 Cement grout  Bentonite 4 Other .....

Grout Intervals: From **0** ft. to **20** ft., From ..... ft. to ..... ft., From ..... ft. to ..... ft.

What is the nearest source of possible contamination:  
 1 Septic tank 4 Lateral lines 7 Pit privy 10 Livestock pens 14 Abandoned water well  
 2 Sewer lines 5 Cess pool  Sewage lagoon 11 Fuel storage 15 Oil well/Gas well  
 3 Watertight sewer lines 6 Seepage pit 9 Feedyard 12 Fertilizer storage 16 Other (specify below)  
 13 Insecticide storage .....

Direction from well? **North** How many feet? **600 ft**

FROM	TO	LITHOLOGIC LOG	FROM	TO	PLUGGING INTERVALS
0	2	Topsoil			
2	52	Clay, tan			
52	91	Clay, gray			
91	123	Sands, fine w/ clay layers			
123	--	Shale, red			

7 CONTRACTOR'S OR LANDOWNER'S CERTIFICATION: This water well was ( constructed, (2) reconstructed, or (3) plugged under my jurisdiction and was completed on (mo/day/year) ..... **12/14/05** ..... and this record is true to the best of my knowledge and belief. Kansas Water Well Contractor's Licence No ..... **138** ..... This Water Well Record was completed on (mo/day/yr) ..... **12/15/05** ..... under the business name of **Peterson Irrigation, Inc.** by (signature) *Michael Peterson*