

EVO 86

EVO 86

WATER WELL RECORD


Form WWC-5

Division of Water Resources App. No.

1 LOCATION OF WATER WELL: Fraction NE 1/4 NW 1/4 1/4 1/4 Section Number 22 Township No. T 18 S Range Number R 3 E W
 County: McPherson
 Street/Rural Address of Well Location; if unknown, distance & direction from nearest town or intersection: If at owner's address, check here
 1500 Pueblo Road
 McPherson, Kansas

Global Positioning System (GPS) information:
 Latitude: 38.476139 (in decimal degrees)
 Longitude: 99.641182 (in decimal degrees)
 Elevation: 579.96
 Datum: WGS 84 NAD 83 NAD 27
 Collection Method:
 GPS unit (Make/Model:)
 Digital Map/Photo, Topographic Map, Land Survey
 Est. Accuracy: <3 m, 3-5 m, 5-15 m, >15 m

2 WATER WELL OWNER: CENWK - Kansas City Division
 RR#, Street Address, Box #: 601 E 12th Street - Room 460
 City, State, ZIP Code : Kansas City, Missouri 64106

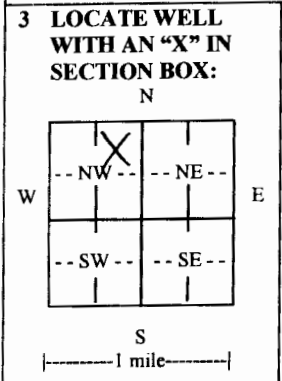

4 DEPTH OF COMPLETED WELL 65 ft.
 Depth(s) Groundwater Encountered (1)..... 40 ft. (2)..... ft. (3)..... ft.
 WELL'S STATIC WATER LEVEL..... NA ft. below land surface measured on mo/day/yr.....
 Pump test data: Well water was NA ft. after hours pumping gpm
 EST. YIELD..... NA gpm. Well water was ft. after hours pumping gpm
 Bore Hole Diameter 8 in. to 70 ft., and in. to ft.
 WELL WATER TO BE USED AS: Public water supply Geothermal Injection well
 Domestic Feedlot Oil field water supply Dewatering Other (Specify below)
 Irrigation Industrial Domestic-lawn & garden Monitoring well
 Was a chemical/bacteriological sample submitted to Department? Yes No
 If yes, mo/day/yr sample was submitted.....
 Water well disinfected? Yes No

5 TYPE OF CASING USED: Steel PVC Other
 CASING JOINTS: Glued Clamped Welded Threaded
 Casing diameter 4 in. to 45 ft., Diameter in. to ft., Diameter in. to ft.
 Casing height above land surface 0.5 in., Weight 2 lbs./ft., Wall thickness or gauge No.
 TYPE OF SCREEN OR PERFORATION MATERIAL:
 Steel Stainless Steel PVC Other (Specify)
 Brass Galvanized Steel None used (open hole)
 SCREEN OR PERFORATION OPENINGS ARE:
 Continuous slot Mill slot Gauze wrapped Torch cut Drilled holes None (open hole)
 Louvered shutter Key punched Wire wrapped Saw cut Other (specify)
 SCREEN-PERFORATED INTERVALS: From 65 ft. to 45 ft., From ft. to ft.
 From ft. to ft., From ft. to ft.
 GRAVEL PACK INTERVALS: From 70 ft. to 41 ft., From ft. to ft.
 From ft. to ft., From ft. to ft.

6 GROUT MATERIAL: Neat cement Cement grout Bentonite Other .. *High solids bent. Grout* ..
 Grout Intervals: From 41 ft. to 3 ft., From ft. to ft., From ft. to ft.
 What is the nearest source of possible contamination:
 Septic tank Lateral lines Pit privy Livestock pens Insecticide storage Other (specify below)
 Sewer lines Cesspool Sewage lagoon Fuel storage Abandoned water well
 Watertight sewer lines Seepage pit Feedyard Fertilizer storage Oil well/gas well ..
 Direction from well Distance from well

FROM	TO	LITHOLOGIC LOG	FROM	TO	LITHO. LOG (cont.) or PLUGGING INTERVALS
0	66	Sandy silty clay			
66	70	Hard clay			

7 CONTRACTOR'S OR LANDOWNER'S CERTIFICATION: This water well was constructed, reconstructed, or plugged under my jurisdiction and was completed on (mo/day/year) 05/17/2013 and this record is true to the best of my knowledge and belief.
 Kansas Water Well Contractor's License No. 597 This Water Well Record was completed on (mo/day/year) 05/17/2013
 under the business name of Boart Longyear Cascade by (signature) Randy Rault

INSTRUCTIONS: Use typewriter or ball point pen. PLEASE PRESS FIRMLY and PRINT clearly. Please fill in blanks and check the correct answers. Send three copies (white, blue, pink) to Kansas Department of Health and Environment, Bureau of Water, Geology Section, 1000 SW Jackson St., Suite 420, Topeka, Kansas 66612-1367. Telephone 785-296-5524. Send one copy to WATER WELL OWNER and retain one for your records. Include fee of \$5.00 for each constructed well. Visit us at <http://www.kdheks.gov/waterwell/index.html>.