

**WATER WELL PLUGGING RECORD Form WWC-5P**

KSA 82a-1212

ID NO.

EVO-03


<b>1 LOCATION OF WATER WELL:</b> County: McPherson	Fraction ¼    ¼ NE ¼ NW ¼	Section Number 22	Township Number T 18 S	Range Number 3 <input type="checkbox"/> E <input checked="" type="checkbox"/> W
---	------------------------------	----------------------	---------------------------	--

Street/Rural Address of Well Location; if unknown, distance & direction from nearest town or intersection: If at owner's address, check here  1500 Pueblo Road  
McPherson, Kansas 67460

**Global Positioning Systems (GPS) information:**  
Latitude: 38.476712 (in decimal degrees)  
Longitude: -97.642825 (in decimal degrees)  
Elevation: 1518.68  
Horizontal Datum:  WGS84,  NAD83,  NAD27  
Collection Method:

**2 WATER WELL OWNER:** USACE - CENWK (KS City)  
RR#, St. Address, Box #: 601 E 12th Street - Room 460  
City, State ZIP Code: Kansas City, Missouri 64106

GPS unit (Make/Model: \_\_\_\_\_)  
 Digital Map/Photo,  Topographic Map,  Land Survey  
Est. Accuracy:  < 3 m,  3-5 m,  5-15 m,  > 15 m

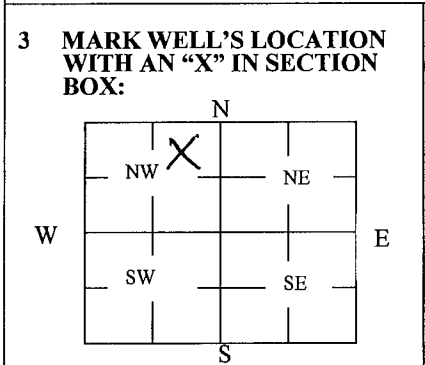

**4 DEPTH OF WELL** 67.30 ft.  
**WELL'S STATIC WATER LEVEL** ≈ 35' ft.  
**WELL WAS USED AS:**  
 Domestic     Public Water Supply     Dewatering  
 Irrigation     Oil Field Water Supply     Monitoring  
 Feedlot     Domestic (Lawn & Garden)     Injection Well  
 Industrial     Air Conditioning     Other \_\_\_\_\_  
Was a chemical/bacteriological sample submitted to Department? Yes  No

**5 TYPE OF BLANK CASING USED:**  
 Steel     RMP (SR)     Wrought     Fiberglass     Other (Specify below)  
 PVC     ABS     Asbestos-Cement     Concrete Tile  
Blank casing diameter 4 in. Was casing pulled? Yes  No  If yes, how much About 3 feet  
Casing height above or below land surface -0.5 in.

**6 GROUT PLUG MATERIAL:**  Neat cement     Cement grout     Bentonite     Other \_\_\_\_\_  
Grout Plug Intervals: From 2 ft. to 67.3 ft., From \_\_\_\_\_ ft. to \_\_\_\_\_ ft., From \_\_\_\_\_ ft. to \_\_\_\_\_ ft.  
What is the nearest source of possible contamination:  
 Septic tank     Seepage pit     Fuel storage     Other (specify below)  
 Sewer lines     Pit privy     Fertilizer storage  
 Watertight sewer lines     Sewage lagoon     Insecticide storage  
 Lateral lines     Feedyard     Abandoned water well    Direction from well? \_\_\_\_\_  
 Cess pool     Livestock pens     Oil well/Gas well    How many feet? \_\_\_\_\_

FROM	TO	PLUGGING MATERIALS	FROM	TO	PLUGGING MATERIALS
0	2	Top soil			
2	67.3	Bentonite			

**7 CONTRACTOR'S OR LANDOWNER'S CERTIFICATION:** This water well was plugged under my jurisdiction and was completed on (mo/day/year) 11-29-17 and this record is true to the best of my knowledge and belief. Kansas Water Well Contractor's License No. 597. This Water Well Record was completed on (mo/day/year) 11-29-17 under the business name of Los Alamos Technical Associates, Inc. Cascade by (signature) Paul Welch, C.E.

Send one white copy to Kansas Department of Health & Environment, Geology Section, 1000 SW Jackson Street, Ste. 420, Topeka, KS 66612-1367. Send one copy to WATER WELL OWNER and retain one for your records.  
Visit us at <http://www.kdheks.gov/waterwell/index.html> Telephone 785-296-5524.