WATER WELL PLUGGING RECORD **Form WWC-5P** **KSA 82a-1212** **ID NO.** EVO-60

1 LOCATION OF WATER WELL: County: McPherson	Fraction ¼ ¼ NE ¼ NW ¼	Section Number 22	Township Number T 18 S	Range Number 3 ☐ E ☑ W

Street/Rural Address of Well Location; if unknown, distance & direction from nearest town or intersection: If at owner's address, check here ☐ 1500 Pueblo Road McPherson, Kansas 67460

Global Positioning Systems (GPS) information:
Latitude: 38.476502 (in decimal degrees)
Longitude: -97.641766 (in decimal degrees)
Elevation: 1524.77
Horizontal Datum: ☑ WGS84, ☑ ~~NAD83~~, ☐ NAD27
Collection Method:
☐ GPS unit (Make/Model: _____
☐ Digital Map/Photo, ☐ Topographic Map, ☑ Land Survey
Est. Accuracy: ☑ <3 m, ☐ 3-5 m, ☐ 5-15 m, ☐ >15 m

2 WATER WELL OWNER: USACE - CENWK (KS City)
RR#, St. Address, Box #: 601 E 12th Street - Room 460
City, State ZIP Code: Kansas City, Missouri 64106

3 MARK WELL'S LOCATION WITH AN "X" IN SECTION BOX:

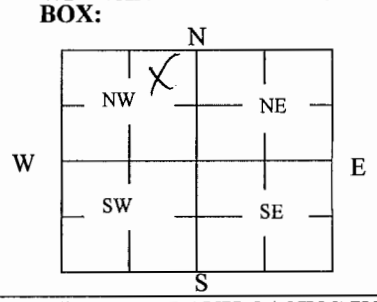

4 DEPTH OF WELL 65.5 ft.

WELL'S STATIC WATER LEVEL _____ ft

WELL WAS USED AS:

☐ Domestic ☐ Irrigation ☐ Feedlot ☐ Industrial
☐ Public Water Supply ☐ Oil Field Water Supply ☐ Domestic (Lawn & Garden) ☐ Air Conditioning
☐ Dewatering ☐ Monitoring ☑ Injection Well ☐ Other _____

Was a chemical/bacteriological sample submitted to Department? Yes ☐ No ☑

5 TYPE OF BLANK CASING USED:

☐ Steel ☑ PVC ☐ RMP (SR) ☐ ABS ☐ Wrought ☐ Asbestos-Cement ☐ Fiberglass ☐ Concrete Tile ☐ Other (Specify below) _____

Blank casing diameter 4 in. Was casing pulled? Yes ☑ No ☐ If yes, how much About 3 feet
Casing height above or below land surface -0.5 in.

6 GROUT PLUG MATERIAL: ☐ Neat cement ☐ Cement grout ☑ Bentonite ☐ Other _____

Grout Plug Intervals: From 2 ft. to 65.5 ft., From _____ ft. to _____ ft., From _____ ft. to _____ ft.

What is the nearest source of possible contamination:

☐ Septic tank ☐ Sewer lines ☐ Watertight sewer lines ☐ Lateral lines ☐ Cess pool
☐ Seepage pit ☐ Pit privy ☐ Sewage lagoon ☐ Feedyard ☐ Livestock pens
☐ Fuel storage ☐ Fertilizer storage ☐ Insecticide storage ☐ Abandoned water well ☐ Oil well/Gas well
☐ Other (specify below) _____
Direction from well? _____
How many feet? _____

FROM	TO	PLUGGING MATERIALS	FROM	TO	PLUGGING MATERIALS
0	2	Top soil			
2	65.5	Bentonite			

7 CONTRACTOR'S OR LANDOWNER'S CERTIFICATION: This water well was plugged under my jurisdiction and was completed on (mo/day/year) 12.5.17 and this record is true to the best of my knowledge and belief. Kansas Water Well Contractor's License No. 597. This Water Well Record was completed on (mo/day/year) 12.12.17 under the business name of Los Alamos Technical Associates, Inc/Cascade by (signature) [signature], CPG

Send one white copy to Kansas Department of Health & Environment, Geology Section, 1000 SW Jackson Street, Ste. 420, Topeka, KS 66612-1367. Send one copy to WATER WELL OWNER and retain one for your records.
Visit us at http://www.kdheks.gov/waterwell/index.html Telephone 785-296-5524.