

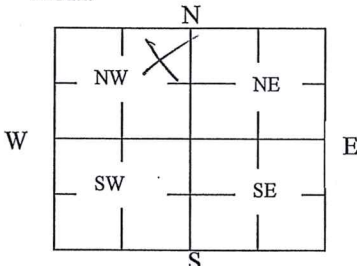
## WATER WELL PLUGGING RECORD

Form WWC-5P

KSA 82a-1212

ID NO.

6MW-511

<b>1 LOCATION OF WATER WELL:</b> County: McPherson	Fraction $\frac{1}{4}$ $\frac{1}{4}$ NE $\frac{1}{4}$ NW $\frac{1}{4}$	Section Number 22	Township Number T 18 S	Range Number 3 <input type="checkbox"/> E <input checked="" type="checkbox"/> W	
Street/Rural Address of Well Location; if unknown, distance & direction from nearest town or intersection: If at owner's address, check here <input type="checkbox"/> 1500 Pueblo Road McPherson, Kansas 67460		<b>Global Positioning Systems (GPS) information:</b> Latitude: <u>38.476488</u> (in decimal degrees) Longitude: <u>-97.640144</u> (in decimal degrees) Elevation: <u>1533.21</u> Horizontal Datum: <input checked="" type="checkbox"/> WGS84, <input checked="" type="checkbox"/> NAD83, <input type="checkbox"/> NAD27 Collection Method:	
<b>2 WATER WELL OWNER:</b> USACE - CENWK (KS City) RR#, St. Address, Box #: 601 E 12th Street - Room 460 City, State ZIP Code: Kansas City, Missouri 64106		<input type="checkbox"/> GPS unit (Make/Model: _____) <input type="checkbox"/> Digital Map/Photo, <input type="checkbox"/> Topographic Map, <input checked="" type="checkbox"/> Land Survey Est. Accuracy: <input checked="" type="checkbox"/> < 3 m, <input type="checkbox"/> 3-5 m, <input type="checkbox"/> 5-15 m, <input type="checkbox"/> > 15 m	
<b>3 MARK WELL'S LOCATION WITH AN "X" IN SECTION BOX:</b> 	<b>4 DEPTH OF WELL</b> <u>55.4</u> ft. WELL'S STATIC WATER LEVEL <u>~39</u> ft. WELL WAS USED AS: <div style="display: flex; justify-content: space-between;"> <div> <input type="checkbox"/> Domestic  <input type="checkbox"/> Irrigation  <input type="checkbox"/> Feedlot  <input type="checkbox"/> Industrial         </div> <div> <input type="checkbox"/> Public Water Supply  <input type="checkbox"/> Oil Field Water Supply  <input type="checkbox"/> Domestic (Lawn &amp; Garden)  <input type="checkbox"/> Air Conditioning         </div> <div> <input type="checkbox"/> Dewatering  <input checked="" type="checkbox"/> Monitoring  <input type="checkbox"/> Injection Well  <input type="checkbox"/> Other _____         </div> </div> Was a chemical/bacteriological sample submitted to Department? Yes <input type="checkbox"/> No <input checked="" type="checkbox"/>	
<b>5 TYPE OF BLANK CASING USED:</b> <div style="display: flex; justify-content: space-between;"> <div> <input type="checkbox"/> Steel  <input checked="" type="checkbox"/> PVC         </div> <div> <input type="checkbox"/> RMP (SR)  <input type="checkbox"/> ABS         </div> <div> <input type="checkbox"/> Wrought  <input type="checkbox"/> Asbestos-Cement         </div> <div> <input type="checkbox"/> Fiberglass  <input type="checkbox"/> Concrete Tile         </div> <div> <input type="checkbox"/> Other (Specify below) _____         </div> </div> Blank casing diameter <u>2</u> in. Was casing pulled? Yes <input checked="" type="checkbox"/> No <input type="checkbox"/> If yes, how much <u>About 3 feet bgs</u> Casing height above or below land surface <u>+2.0</u> in.	
<b>6 GROUT PLUG MATERIAL:</b> <input type="checkbox"/> Neat cement <input type="checkbox"/> Cement grout <input checked="" type="checkbox"/> Bentonite <input type="checkbox"/> Other _____ Grout Plug Intervals: From <u>2</u> ft. to <u>55.4</u> ft., From _____ ft. to _____ ft., From _____ ft. to _____ ft. What is the nearest source of possible contamination: <div style="display: flex; justify-content: space-between;"> <div> <input type="checkbox"/> Septic tank  <input type="checkbox"/> Sewer lines  <input type="checkbox"/> Watertight sewer lines  <input type="checkbox"/> Lateral lines  <input type="checkbox"/> Cess pool         </div> <div> <input type="checkbox"/> Seepage pit  <input type="checkbox"/> Pit privy  <input type="checkbox"/> Sewage lagoon  <input type="checkbox"/> Feedyard  <input type="checkbox"/> Livestock pens         </div> <div> <input type="checkbox"/> Fuel storage  <input type="checkbox"/> Fertilizer storage  <input type="checkbox"/> Insecticide storage  <input type="checkbox"/> Abandoned water well  <input type="checkbox"/> Oil well/Gas well         </div> <div> <input type="checkbox"/> Other (specify below) _____          Direction from well? _____          How many feet? _____         </div> </div> <table border="1" style="width:100%; border-collapse: collapse; margin-top: 10px;"> <thead> <tr> <th>FROM</th> <th>TO</th> <th>PLUGGING MATERIALS</th> <th>FROM</th> <th>TO</th> <th>PLUGGING MATERIALS</th> </tr> </thead> <tbody> <tr> <td>0</td> <td>2</td> <td>Top soil</td> <td></td> <td></td> <td></td> </tr> <tr> <td>2</td> <td>55.4</td> <td>Bentonite</td> <td></td> <td></td> <td></td> </tr> <tr><td> </td><td> </td><td> </td><td> </td><td> </td><td> </td></tr> <tr><td> </td><td> </td><td> </td><td> </td><td> </td><td> </td></tr> <tr><td> </td><td> </td><td> </td><td> </td><td> </td><td> </td></tr> <tr><td> </td><td> </td><td> </td><td> </td><td> </td><td> </td></tr> <tr><td> </td><td> </td><td> </td><td> </td><td> </td><td> </td></tr> <tr><td> </td><td> </td><td> </td><td> </td><td> </td><td> </td></tr> </tbody> </table>					FROM	TO	PLUGGING MATERIALS	FROM	TO	PLUGGING MATERIALS	0	2	Top soil				2	55.4	Bentonite																																							
FROM	TO	PLUGGING MATERIALS	FROM	TO	PLUGGING MATERIALS	
0	2	Top soil	
2	55.4	Bentonite	
<b>7 CONTRACTOR'S OR LANDOWNER'S CERTIFICATION:</b> This water well was plugged under my jurisdiction and was completed on (mo/day/year) <u>12/7/17</u> and this record is true to the best of my knowledge and belief. Kansas Water Well Contractor's License No. <u>599</u> . This Water Well Record was completed on (mo/day/year) <u>12/12/17</u> under the business name of <u>Los Alamos Technical Associates, Inc.</u> by (signature) <u>[Signature]</u>	
Send one white copy to Kansas Department of Health & Environment, Geology Section, 1000 SW Jackson Street, Ste. 420, Topeka, KS 66612-1367. Send one copy to WATER WELL OWNER and retain one for your records. Visit us at <a href="http://www.kdheks.gov/waterwell/index.html">http://www.kdheks.gov/waterwell/index.html</a> Telephone 785-296-5524.	