


1 LOCATION OF WATER WELL:
 County: McPherson Fraction 1/4 C E 1/2 NE 1/4 Section Number 21 Township Number T 18 S Range Number R 3 E W

Distance and direction from nearest town or city street address of well if located within city?
McPherson County Landfill

2 WATER WELL OWNER: McPherson County
 RR#, St. Address, Box #: Courthouse Board of Agriculture, Division of Water Resources
 City, State, ZIP Code: McPherson, Kansas 67460 Application Number:

3 LOCATE WELL'S LOCATION WITH AN "X" IN SECTION BOX:

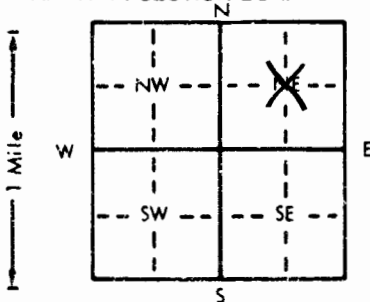

4 DEPTH OF COMPLETED WELL: 52 ft. ELEVATION: _____

Depth(s) Groundwater Encountered 1. 42 ft. 2. _____ ft. 3. _____ ft.

WELL'S STATIC WATER LEVEL 42.5 ft. TOC measured on mo/day/yr

Pump test data: Well water was _____ ft. after _____ hours pumping _____ gpm

Est. Yield _____ gpm: Well water was _____ ft. after _____ hours pumping _____ gpm

Bore Hole Diameter 8 in. to 52 ft., and _____ in. to _____ ft.

WELL WATER TO BE USED AS: 5 Public water supply 8 Air conditioning 11 Injection well!
 1 Domestic 3 Feedlot 6 Oil field water supply 9 Dewatering 12 Other (Specify below)
 2 Irrigation 4 Industrial 7 Lawn and garden only 10 Monitoring well

Was a chemical/bacteriological sample submitted to Department? Yes _____ No X; If yes, mo/day/yr sample was sub-
 mitted _____ Water Well Disinfected? Yes _____ No X

5 TYPE OF BLANK CASING USED:

1 Steel	3 RMP (SR)	5 Wrought iron	8 Concrete tile	CASING JOINTS: Glued _____ Clamped _____
2 <u>PVC</u>	4 ABS	6 Asbestos-Cement	9 Other (specify below)	Welded _____
Blank casing diameter <u>2</u> in. to <u>37</u> ft., Dia _____ in. to _____ ft., Dia _____ in. to _____ ft.	7 Fiberglass			Threaded <u>X</u>

Casing height above land surface 30 in., weight _____ lbs./ft. Wall thickness or gauge No. sch. 40

TYPE OF SCREEN OR PERFORATION MATERIAL:

1 Steel	3 Stainless steel	5 Fiberglass	8 RMP (SR)	10 Asbestos-cement
2 Brass	4 Galvanized steel	6 Concrete tile	9 ABS	11 Other (specify) _____
SCREEN OR PERFORATION OPENINGS ARE:				
1 Continuous slot	3 <u>Mill slot</u>	5 Gauzed wrapped	8 Saw cut	11 None (open hole)
2 Louvered shutter	4 Key punched	6 Wire wrapped	9 Drilled holes	
7 Torch cut	10 Other (specify) _____			

SCREEN-PERFORATED INTERVALS: From 37 ft. to 52 ft., From _____ ft. to _____ ft.

GRAVEL PACK INTERVALS: From 34 ft. to 52 ft., From _____ ft. to _____ ft.

6 GROUT MATERIAL: 1 Neat cement 2 Cement grout 3 Bentonite 4 Other _____

Grout Intervals: From 0 ft. to 4 ft., From 4 ft. to 34 ft., From _____ ft. to _____ ft.


What is the nearest source of possible contamination:

1 Septic tank	4 Lateral lines	7 Pit privy	10 Livestock pens	14 Abandoned water well
2 Sewer lines	5 Cess pool	8 Sewage lagoon	11 Fuel storage	15 Oil well/Gas well
3 Watertight sewer lines	6 Seepage pit	9 Feedyard	12 Fertilizer storage	16 <u>Other (specify below)</u>
			13 Insecticide storage	<u>Unknown</u>

Direction from well? _____ How many feet? _____

FROM	TO	LITHOLOGIC LOG	FROM	TO	PLUGGING INTERVALS
0	1	Topsoil			
1	2	Very dark brown clay			
2	9	Dark brown clay			
9	53	Red brown silty clay			

MW1.2S

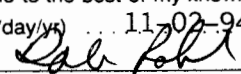7 CONTRACTOR'S OR LANDOWNER'S CERTIFICATION: This water well was (1) constructed, (2) reconstructed, or (3) plugged under my jurisdiction and was completed on (mo/day/year) 02-01-94 and this record is true to the best of my knowledge and belief. Kansas Water Well Contractor's License No. 527. This Water Well Record was completed on (mo/day/yr) 11-02-94 under the business name of GeoCore Services, Inc. by (signature) 

INSTRUCTIONS: Use typewriter or ball point pen. PLEASE PRESS FIRMLY and PRINT clearly. Please fill in blanks, underline or circle the correct answers. Send top three copies to Kansas Department of Health and Environment, Bureau of Water, Topeka, Kansas 66620-0001. Telephone: 913-296-5545. Send one to WATER WELL OWNER and retain one for your records.