


1 LOCATION OF WATER WELL: County: <b>Lane</b>	Fraction <b>NW</b> ¼ <b>NE</b> ¼ <b>SW</b> ¼	Section Number <b>6</b>	Township Number T <b>18</b> S	Range Number R <b>30</b> E/W
--------------------------------------------------	-------------------------------------------------	----------------------------	----------------------------------	---------------------------------

Distance and direction from nearest town or city street address of well if located within city?  
**2 w, 6 s, 1 ½ w, n INTO FROM HEALY**

2 WATER WELL OWNER: **Jon Ramsey**  
 RR#, St. Address, Box # : **10200 E Rd 170**  
 City, State, ZIP Code : **Scott City, Ks 67871**  
 Board of Agriculture, Division of Water Resources  
 Application Number: **20050053**

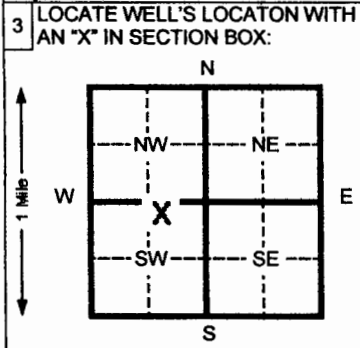

4 DEPTH OF COMPLETED WELL **133** ft. ELEVATION: \_\_\_\_\_

Depth(s) Groundwater Encountered 1 \_\_\_\_\_ ft. 2 \_\_\_\_\_ ft. 3 \_\_\_\_\_ ft.

WELL'S STATIC WATER LEVEL **na** ft. below land surface measured on mo/day/yr \_\_\_\_\_

Pump test data: Well water was \_\_\_\_\_ ft. after \_\_\_\_\_ hours pumping \_\_\_\_\_ gpm

Est. Yield \_\_\_\_\_ gpm: Well water was \_\_\_\_\_ ft. after \_\_\_\_\_ hours pumping \_\_\_\_\_ gpm

Bore Hole Diameter **8** in. to **133** ft. and \_\_\_\_\_ in. to \_\_\_\_\_ ft.

WELL WATER TO BE USED AS: 5 Public water supply 8 Air conditioning 11 Injection well  
 1 Domestic 3 Feed lot **6** Oil field water supply 9 Dewatering 12 Other (Specify below)  
 2 Irrigation 4 Industrial 7 Lawn and garden (domestic) 10 Monitoring well

Was a chemical/bacteriological sample submitted to Department? Yes \_\_\_\_\_ No **X** If yes, mo/day/yr sample was submitted \_\_\_\_\_

Water Well Disinfected? Yes **X** No \_\_\_\_\_

5 TYPE OF BLANK CASING USED:

1 Steel	3 RMP (SR)	5 Wrought Iron	8 Concrete tile	CASING JOINTS: Glued <b>X</b> Clamped _____
<b>2</b> PVC	4 ABS	6 Asbestos-Cement	9 Other (specify below) _____	Welded _____
Blank casing diameter <b>4.5</b> in. to <b>93</b> ft., Dia _____ in. to _____ ft., Dia _____ in. to _____ ft.	7 Fiberglass _____	Threaded _____		

Casing height above land surface **24** in., weight **2,384** lbs./ft. Wall thickness or gauge No. **.248**

TYPE OF SCREEN OR PERFORATION MATERIAL:

1 Steel	3 Stainless steel	5 Fiberglass	<b>7</b> PVC	10 Asbestos-cement
2 Brass	4 Galvanized steel	6 Concrete tile	8 RMP (SR)	11 Other (specify) _____
SCREEN OR PERFORATION OPENINGS ARE:		5 Gauzed wrapped	<b>8</b> Saw cut	11 None (open hole)
1 Continuous slot	3 Mill slot	6 Wire wrapped	9 Drilled holes	
2 Louvered shutter	4 Key punched	7 Torch cut	10 Other (specify) _____	

SCREEN-PERFORATED INTERVALS: From **93** ft. to **133** ft. From \_\_\_\_\_ ft. to \_\_\_\_\_ ft.

GRAVEL PACK INTERVALS: From **20** ft. to **133** ft. From \_\_\_\_\_ ft. to \_\_\_\_\_ ft.

6 GROUT MATERIAL: 1 Neat cement 2 Cement grout **3** Bentonite 4 Other \_\_\_\_\_

Grout Intervals From **0** ft. to **20** ft. From \_\_\_\_\_ ft. to \_\_\_\_\_ ft. From \_\_\_\_\_ ft. to \_\_\_\_\_ ft.

What is the nearest source of possible contamination:

1 Septic tank	4 Lateral lines	7 Pit privy	10 Livestock pens	14 Abandoned water well
2 Sewer lines	5 Cess pool	8 Sewage lagoon	11 Fuel storage	15 Oil well/ Gas well
3 Watertight sewer lines	6 Seepage pit	9 Feedyard	12 Fertilizer storage	16 Other (specify below)
			13 Insecticide storage	<b>Oil well</b>

Direction from well? **W** How many feet? **150**

FROM	TO	CODE	LITHOLOGIC LOG	FROM	TO	PLUGGING INTERVALS
<b>0</b>	<b>3</b>		<b>Surface</b>			<b>Layers</b>
<b>3</b>	<b>15</b>		<b>loess</b>	<b>110</b>	<b>111</b>	<b>Hard caliche</b>
<b>15</b>	<b>31</b>		<b>clay &amp; caliche</b>	<b>111</b>	<b>126</b>	<b>Med sand w/clay</b>
<b>31</b>	<b>38</b>		<b>Cemented sand w/sand strks</b>	<b>126</b>	<b>130</b>	<b>Ochre</b>
<b>38</b>	<b>50</b>		<b>Caliche cemented sand &amp; clay</b>	<b>130</b>	<b>133</b>	<b>shale</b>
			<b>Some sand</b>			
<b>50</b>	<b>53</b>		<b>Sandy clay w/some sand</b>			
<b>53</b>	<b>54</b>		<b>Sandy clay, med sand</b>			
<b>54</b>	<b>56</b>		<b>Fairly hard cemented sand</b>			
<b>56</b>	<b>63</b>		<b>Med sand w/clay</b>			
<b>63</b>	<b>70</b>		<b>Cemented sand &amp; caliche w/</b>			
			<b>Clay &amp; some sand</b>			
<b>70</b>	<b>90</b>		<b>Med sand &amp; gravel, fairly loose</b>			
<b>90</b>	<b>110</b>		<b>Fine to med w/clay &amp; caliche</b>			

7 CONTRACTOR'S OR LANDOWNER'S CERTIFICATION: This water well was (1) constructed, (2) reconstructed, or (3) plugged under my jurisdiction and was completed on (mo/day/yr) **2-19-05** and this record is true to the best of my knowledge and belief. Kansas Water Well Contractor's License No. **554** This Water Well Record was completed on (mo/day/yr) **3-25-05** under the business name of **Woofter Pump & Well Inc.** by (signature) **2-25-05**

INSTRUCTIONS: Please fill in blanks and circle the correct answers. Send three copies to Kansas Department of Health and Environment, Bureau of Water, 10005 W Jackson St., Ste. 420, Topeka, Kansas 66612-1367. Telephone: 913-296-5545. Send one to WATER WELL OWNER and retain one for your records.