

WATER WELL RECORD

Form WWC-5


Division of Water Resources App. No. 20110011

| | | | | |
|----------------------------------|---|-----------------------------|----------------------------------|--|
| 1 LOCATION OF WATER WELL: | Fraction Lane SW ¼ NW ¼ SW ¼ SE ¼ | Section Number 13 | Township Number T 18 S | Range Number R 30 <input type="checkbox"/> E <input checked="" type="checkbox"/> W |
|----------------------------------|---|-----------------------------|----------------------------------|--|

Street/Rural Address of Well Location; if unknown, distance & direction from nearest town or intersection: If at owner's address, check here
750 ft from south line—2550 ft from east line

Global Positioning System (GPS) information:
 Latitude: _____ (in decimal degrees)
 Longitude: _____ (in decimal degrees)
 Elevation: _____
 Datum: WGS 84, NAD 83, NAD 27
 Collection Method:
 GPS unit (Make/Model: _____)
 Digital Map/Photo, Topographic Map, Land Survey
 Est. Accuracy: <3 m, 3-5 m, 5-15 m, >15 m

2 WATER WELL OWNER: Marvin & Wanda Pinkston
 RR#, St. Address, Box # PO Box 55
 City, State, ZIP Code Dighton, KS 67839

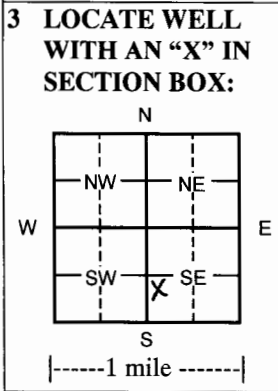

4 DEPTH OF COMPLETED WELL 105 ft.
 Depth(s) Groundwater Encountered (1) _____ ft. (2) _____ ft. (3) _____ ft.
 WELL'S STATIC WATER LEVEL NA ft. below land surface measured on mo/day/yr _____
 Pump test data: Well water was _____ ft. after _____ hours pumping _____ gpm
 EST. YIELD _____ gpm: Well water was _____ ft. after _____ hours pumping _____ gpm
 WELL WATER TO BE USED AS: Public water supply Geothermal Injection well
 Domestic Feedlot Oil field water supply Dewatering Other (Specify below)
 Irrigation Industrial Domestic-lawn & garden Monitoring well
 Was a chemical/bacteriological sample submitted to Department? Yes No
 If yes, mo/day/yr sample was submitted _____
 Water Well Disinfected? Yes No

5 TYPE OF CASING USED: Steel PVC Other _____
 CASING JOINTS: Glued Clamped Welded Threaded
 Casing diameter 4.5 in. to 65 ft., Diameter _____ in. to _____ ft., Diameter _____ in. to _____ ft.
 Casing height above land surface 18 in., Weight 2.38 lbs./ft. Wall thickness or gauge No. .248

TYPE OF SCREEN OR PERFORATION MATERIAL:
 Steel Stainless Steel PVC Other (Specify) _____
 Brass Galvanized Steel None used (open hole)

SCREEN OR PERFORATION OPENINGS ARE:
 Continuous Slot Mill slot Gauze wrapped Torch cut Drilled holes None (open hole)
 Louvered shutter Key punched Wire wrapped Saw cut Other (specify) _____

SCREEN-PERFORATED INTERVALS:
 From 65 ft. to 105 ft., From _____ ft. to _____ ft.
 From _____ ft. to _____ ft., From _____ ft. to _____ ft.
 From _____ ft. to _____ ft., From _____ ft. to _____ ft.

GRAVEL PACK INTERVALS:
 From 20 ft. to 105 ft., From _____ ft. to _____ ft.
 From _____ ft. to _____ ft., From _____ ft. to _____ ft.

6 GROUT MATERIAL: Neat cement Cement grout Bentonite Other _____
 Grout Intervals From 0 ft. to 20 ft. From _____ ft. to _____ ft. From _____ ft. to _____ ft.
 What is the nearest source of possible contamination:
 Septic tank Lateral lines Pit privy Livestock pens Insecticide storage Other (specify below)
 Sewer lines Cesspool Sewage lagoon Fuel storage Abandoned water well
 Watertight sewer lines Seepage pit Feedyard Fertilizer storage Oil well/gas well None
 Direction from well _____ Distance from well _____

| FROM | TO | LITHOLOGIC LOG | FROM | TO | LITHO. LOG (cont.) or PLUGGING INTERVALS |
|------|-----|---|------|-----|--|
| 0 | 2 | Surface | 105 | 140 | Black shale |
| 2 | 8 | Loess | | | |
| 8 | 18 | Clay w/caliche strks | | | |
| 18 | 26 | Sandstone w/clay & caliche strks | | | |
| 26 | 40 | Caliche w/clay lenses | | | |
| 40 | 60 | Sandstone w/caliche & clay strks | | | |
| 60 | 82 | Caliche w/sandstone strks & clay lenses | | | |
| 82 | 86 | Fine sand w/caliche & clay strks | | | |
| 86 | 97 | Caliche w/fine sand strks & clay lenses | | | |
| 97 | 105 | Yellow ochre | | | |

7 CONTRACTOR'S OR LANDOWNER'S CERTIFICATION: This water well was constructed, reconstructed, or plugged under my jurisdiction and was completed on (mo/day/year) 1-3-11 and this record is true to the best of my knowledge and belief.
 Kansas Water Well Contractor's License No. 554 or 783. This Water Well Record was completed on (mo/day/year) 1-12-11
 under the business name of Woofter Pump & Well Inc. by (signature) [Signature]

INSTRUCTIONS: Please fill in blanks and check the correct answers. Send three copies (white, blue, pink) to Kansas Department of Health and Environment, Bureau of Water, Geology Section, 1000 SW Jackson St., Suite 420, Topeka, Kansas 66612-1367. Telephone 785-296-5522. Send one to WATER WELL OWNER and retain one for your records. Include fee of \$5.00 for each constructed well. Visit us at <http://www.kdheks.gov/waterwell/index.html>.