

WATER WELL PLUGGING RECORD

FORM WWC-5P

KSA 82a-1212


| | | | | |
|----------------------------------|-----------------------------|----------------|-----------------|--------------|
| 1 LOCATION OF WATER WELL: | Fraction | Section Number | Township Number | Range Number |
| County: Lane | SW 1/4 NW 1/4 NW 1/4 | 12 | 18 | 30 |

Distance and direction from nearest town or city street address of well if located within city?

6 miles so of Healy, 1 east 1/4 south, east into

2 WATER WELL OWNER: **Mildred Cramer**
 RR#, St. Address, Box # **% Dexter D Cramer POA** Board of Agriculture, Division of Water Resources
 City, State, ZIP Code : **185 N Rural Eagle Rd, Healy, Ks 67850** Application Number: **20100477**

3 MARK WELL'S LOCATON WITH AN "X" IN SECTION BOX:

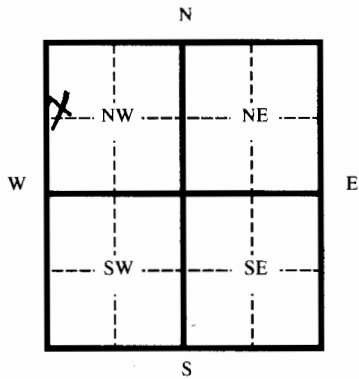

4 DEPTH OF WELL **135** ft.

WELL'S STATIC WATER LEVEL **100** ft.

WELL WAS USED AS:

- | | | |
|--------------|--|--------------------|
| 1 Domestic | 5 Public Water Supply | 9 Dewatering |
| 2 Irrigation | <input checked="" type="checkbox"/> 6 Oil Field Water Supply | 10 Monitoring Well |
| 3 Feedlot | 7 Lawn and Garden (domestic) | 11 Injection Well |
| 4 Industrial | 8 | 12 Other |

Was a chemical/bacteriological sample submitted to Department? Yes _____ No

If yes, mo/day/yr sample was submitted _____

Water Well Disinfected: Yes No _____

5 TYPE OF BLANK CASING USED:

| | | | | |
|---|------------|-------------------|-----------------|-------------------------|
| 1 Steel | 3 RMP (SR) | 5 Wrought | 7 Fiberglass | 9 Other (specify below) |
| <input checked="" type="checkbox"/> 2 PVC | 4 ABC | 6 Asbestos-Cement | 8 Concrete Tile | |

Blank casing diameter **4.5** in. Was casing pulled? Yes No _____ If yes, how much **3 ft**

Casing height above or below land surface **-36** in.

6 GROUT PLUG MATERIAL: 1 Neat cement 2 Cement grout 3 Bentonite 4 Other _____

Grout Plug Intervals From _____ ft. to _____ ft. From _____ ft. to _____ ft. From _____ ft. to _____ ft.

What is the nearest source of possible contamination:

- | | | | |
|--------------------------|-------------------|-------------------------|--------------------------|
| 1 Septic tank | 6 Seepage pit | 11 Fuel storage | 16 Other (specify below) |
| 2 Sewer lines | 7 Pit privy | 12 Fertilizer storage | |
| 3 Watertight sewer lines | 8 Sewage lagoon | 13 Insecticide storage | |
| 4 Lateral lines | 9 Feedyard | 14 Abandoned water well | |
| 5 Cess Pool | 10 Livestock pens | 15 Oil well/ Gas well | |

Direction from well? _____ How many feet? _____

| FROM | TO | CODE | PLUGGING MATERIALS |
|------|-----|------|-------------------------|
| 135 | 100 | | Chlorinated sand |
| 100 | 97 | | Bentonite |
| 97 | 6 | | Native clay |
| 6 | 3 | | Bentonite |
| 3 | 0 | | Native Clay |
| | | | |
| | | | |

7 CONTRACTOR'S OR LANDOWNER'S CERTIFICATION: This water well was plugged under my jurisdiction and was completed on (mo/day/yr) **7-29-2011** and this record is true to the best of my knowledge and belief. Kansas Water Well Contractor's License No. **554** This Water Well Record was completed on (mo/day/yr) **8-2-11** under the business name of **Woofter Pump & Well Inc.** by (signature) *Gary C. Woofter*

INSTRUCTIONS: Please fill in blanks and circle the correct answers. Send three copies to Kansas Department of Health and Environment, Bureau of Water, Topeka, Kansas 66620-0001. Telephone: 785-296-3565. Send one to Water Well Owner and retain one for your records.