

WATER WELL PLUGGING RECORD

FORM WWC-5P

KSA 82a-1212


1 LOCATION OF WATER WELL: Fraction	Section Number	Township Number	Range Number
County: Lane NW 1/4 SW 1/4 SE 1/4	13	18	30 W

Distance and direction from nearest town or city street address of well if located within city?

750 ft from south line—2550 ft from east line

2 WATER WELL OWNER: Marvin & Wanda Pinkston	Board of Agriculture, Division of Water Resources Application Number: 20110011
RR#, St. Address, Box # PO Box 55	
City, State, ZIP Code : Dighton, KS 67839	

3 MARK WELL'S LOCATOR WITH AN "X" IN SECTION BOX:

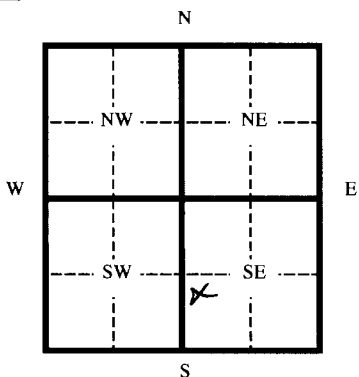

4 DEPTH OF WELL **105** ft.

WELL'S STATIC WATER LEVEL **80** ft.

WELL WAS USED AS:

- 1 Domestic
- 2 Irrigation
- 3 Feedlot
- 4 Industrial
- 5 Public Water Supply
- 6 Oil Field Water Supply
- 7 Lawn and Garden (domestic)
- 8
- 9 Dewatering
- 10 Monitoring Well
- 11 Injection Well
- 12 Other

Was a chemical/bacteriological sample submitted to Department? Yes ___ No **X**

If yes, mo/day/yr sample was submitted _____

Water Well Disinfected: Yes **X** No ___

5 TYPE OF BLANK CASING USED:

- 1 Steel
- 2 PVC
- 3 RMP (SR)
- 4 ABC
- 5 Wrought
- 6 Asbestos-Cement
- 7 Fiberglass
- 8 Concrete Tile
- 9 Other (specify below)

Blank casing diameter **4.5** in. Was casing pulled? Yes ___ No **X** If yes, how much _____

Casing height above or below land surface **-36** in.

6 GROUT PLUG MATERIAL: 1 Neat cement 2 Cement grout **3 Bentonite** 4 Other _____

Grout Plug Intervals From **3** ft. to **6** ft. From **77** ft. to **80** ft. From _____ ft. to _____ ft.

What is the nearest source of possible contamination:

- 1 Septic tank
- 2 Sewer lines
- 3 Watertight sewer lines
- 4 Lateral lines
- 5 Cess Pool
- 6 Seepage pit
- 7 Pit privy
- 8 Sewage lagoon
- 9 Feedyard
- 10 Livestock pens
- 11 Fuel storage
- 12 Fertilizer storage
- 13 Insecticide storage
- 14 Abandoned water well
- 15 Oil well/ Gas well
- 16 Other (specify below) _____

Direction from well? _____ How many feet? _____

FROM	TO	CODE	PLUGGING MATERIALS
105	80		Chlorinated Sand
80	77		Bentonite
77	6		Native Clay
6	3		Bentonite
3	0		Native clay

7 CONTRACTOR'S OR LANDOWNER'S CERTIFICATION: This water well was plugged under my jurisdiction and was completed on (mo/day/yr) **7/20/11** and this record is true to the best of my knowledge and belief. Kansas Water Well Contractor's License No. **554** This Water Well Record was completed on (mo/day/yr) **8-2-11** under the business name of **Woofter Pump & Well Inc.** by (signature) _____

INSTRUCTIONS: Please fill in blanks and circle the correct answers. Send three copies to Kansas Department of Health and Environment, Bureau of Water, Topeka, Kansas 66620-0001. Telephone: 785-296-3565. Send one to Water Well Owner and retain one for your records.