

WATER WELL RECORD Form WWC-5


Original Record Correction Change in Well Use

Division of Water Resources App. No.

Well ID

1 LOCATION OF WATER WELL: County: Lane Fraction NE 1/4 NE 1/4 NW 1/4 NE 1/4 Section Number 36 Township Number T 18 S Range Number R 30 E W

2 WELL OWNER: Last Name: Risley Family Revocable Trust First: Street or Rural Address where well is located (if unknown, distance and direction from nearest town or intersection): If at owner's address, check here:
 Business: Risley Family Revocable Trust
 Address: 64 West Rd. 130
 Address:
 City: Dighton State: Kansas ZIP: 67839

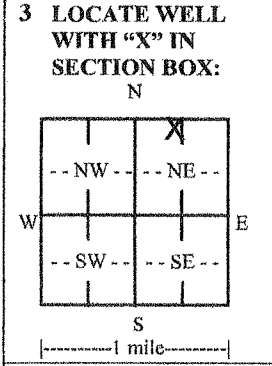

4 DEPTH OF COMPLETED WELL: 120 ft. Depth(s) Groundwater Encountered: 1) 54 ft. 2) ft. 3) ft. or 4) Dry Well
 WELL'S STATIC WATER LEVEL: 54 ft. below land surface, measured on (mo-day-yr) 10/01/2014
 above land surface, measured on (mo-day-yr)
 Pump test data: Well water was ft. after hours pumping gpm
 Well water was ft. after hours pumping gpm
 Estimated Yield: 30 gpm
 Bore Hole Diameter: 9 in. to 120 ft. and in. to ft.

5 Latitude: 38.45263 (decimal degrees)
Longitude: 100.58083 (decimal degrees)
 Datum: WGS 84 NAD 83 NAD 27
 Source for Latitude/Longitude:
 GPS (unit make/model:) (WAAS enabled? Yes No)
 Land Survey Topographic Map
 Online Mapper:
6 Elevation: 2847 ft. Ground Level TOC
 Source: Land Survey GPS Topographic Map
 Other KOLAR

7 WELL WATER TO BE USED AS:

1. Domestic: Household Lawn & Garden Livestock
 2. Irrigation
 3. Feedlot
 4. Industrial
 5. Public Water Supply: well ID
 6. Dewatering: how many wells?
 7. Aquifer Recharge: well ID
 8. Monitoring: well ID
 9. Environmental Remediation: well ID
 Air Sparge Soil Vapor Extraction Recovery Injection
 10. Oil Field Water Supply: lease
 11. Test Hole: well ID
 Cased Uncased Geotechnical
 12. Geothermal: how many bores?
 a) Closed Loop Horizontal Vertical
 b) Open Loop Surface Discharge Inj. of Water
 13. Other (specify):

Was a chemical/bacteriological sample submitted to KDHE? Yes No If yes, date sample was submitted:
 Water well disinfected? Yes No

8 TYPE OF CASING USED: Steel PVC Other CASING JOINTS: Glued Clamped Welded Threaded
 Casing diameter 5 in. to 120 ft., Diameter 14 in. to ft., Diameter in. to ft., Diameter in. to ft.
 Casing height above land surface in. Weight lbs./ft. Wall thickness or gauge No. SDR17
TYPE OF SCREEN OR PERFORATION MATERIAL:
 Steel Stainless Steel Fiberglass PVC Other (Specify)
 Brass Galvanized Steel Concrete tile None used (open hole)
SCREEN OR PERFORATION OPENINGS ARE:
 Continuous Slot Mill Slot Gauze Wrapped Torch Cut Drilled Holes Other (Specify)
 Louvered Shutter Key Punched Wire Wrapped Saw Cut None (Open Hole)
SCREEN-PERFORATED INTERVALS: From 80 ft. to 120 ft., From ft. to ft., From ft. to ft., From ft. to ft.
GRAVEL PACK INTERVALS: From 0 ft. to 6 ft., From 30 ft. to 120 ft., From ft. to ft.

9 GROUT MATERIAL: Neat cement Cement grout Bentonite Other
 Grout intervals: From 6 ft. to 30 ft., From ft. to ft., From ft. to ft., From ft. to ft.
Nearest source of possible contamination:
 Septic Tank Lateral Lines Pit Privy Livestock Pens Insecticide Storage
 Sewer Lines Cess Pool Sewage Lagoon Fuel Storage Abandoned Water Well
 Watertight Sewer Lines Seepage Pit Feedyard Fertilizer Storage Oil Well/Gas Well
 Other (Specify)
 Direction from well? S Distance from well? 6 ft.

10 FROM	TO	LITHOLOGIC LOG	FROM	TO	LITHO. LOG (cont.) or PLUGGING INTERVALS
0	20	Top Soil Brown Clay	80	100	Fine Coarse Sand
20	40	Brown Tan Clay White Soft Rock w/ White Caliche	100	115	Fine Coarse Sand
			115	120	Yellow Clay
40	60	Soft White Rock, Caliche, Fine Sand Streaks	120	140	Blue Clay, Blue Shale
60	65	Hard Solid White Rock			
65	75	White Soft Rock, w/ Fine Sand Streaks & White Caliche	Notes:		
75	80	Fine Med Sand			

11 CONTRACTOR'S OR LANDOWNER'S CERTIFICATION: This water well was constructed, reconstructed, or plugged under my jurisdiction and was completed on (mo-day-year) 10/01/2014 and this record is true to the best of my knowledge and belief. Kansas Water Well Contractor's License No. 846 This Water Well Record was completed on (mo-day-year) 10/13/2014 under the business name of Nash Water Well Service, LLC