


1 LOCATION OF WATER WELL: Fraction NE 1/4 NE 1/4 SW 1/4 Section Number 6 Township Number T 18 S Range Number R 31 E W  
 County: Scott

Distance and direction from nearest town or city street address of well if located within city?  
6 Miles East, 2 1/2 Miles North of Scott City

2 WATER WELL OWNER: Hucks Children Trust Abercrombie RTD  
 RR#, St. Address, Box #: HC65 Box 43 150 Main, Suite 801 Board of Agriculture, Division of Water Resources  
 City, State, ZIP Code: Coldwater, Ks. 67209 Wichita, Ks. 67202 Application Number: 960126

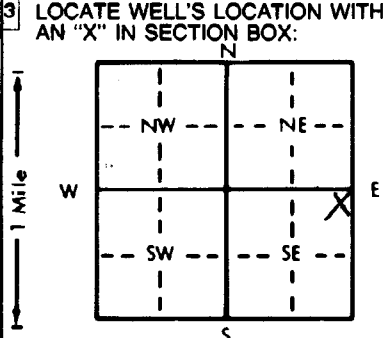

4 DEPTH OF COMPLETED WELL: 175 ft. ELEVATION: \_\_\_\_\_  
 Depth(s) Groundwater Encountered 1. \_\_\_\_\_ ft. 2. \_\_\_\_\_ ft. 3. \_\_\_\_\_ ft.  
 WELL'S STATIC WATER LEVEL: 136 ft. below land surface measured on mo/day/yr \_\_\_\_\_  
 Pump test data: Well water was \_\_\_\_\_ ft. after \_\_\_\_\_ hours pumping \_\_\_\_\_ gpm  
 Est. Yield \_\_\_\_\_ gpm: Well water was \_\_\_\_\_ ft. after \_\_\_\_\_ hours pumping \_\_\_\_\_ gpm  
 Bore Hole Diameter: 8 in. to 175 ft., and \_\_\_\_\_ in. to \_\_\_\_\_ ft.  
 WELL WATER TO BE USED AS:  
 5 Public water supply 8 Air conditioning 11 Injection well  
 1 Domestic 3 Feedlot 6 Oil field water supply 9 Dewatering 12 Other (Specify below)  
 2 Irrigation 4 Industrial 7 Lawn and garden only 10 Monitoring well  
 Was a chemical/bacteriological sample submitted to Department? Yes \_\_\_\_\_ No X; If yes, mo/day/yr sample was sub-  
 mitted \_\_\_\_\_ Water Well Disinfected? Yes \_\_\_\_\_ No X

5 TYPE OF BLANK CASING USED:  
 1 Steel 3 RMP (SR) 5 Wrought iron 8 Concrete tile CASING JOINTS: Glued X Clamped \_\_\_\_\_  
 2 PVC 4 ABS 6 Asbestos-Cement 9 Other (specify below) Welded \_\_\_\_\_  
 7 Fiberglass Threaded \_\_\_\_\_  
 Blank casing diameter: 4.5 in. to 135 ft., Dia \_\_\_\_\_ in. to \_\_\_\_\_ ft., Dia \_\_\_\_\_ in. to \_\_\_\_\_ ft.  
 Casing height above land surface: 18 in., weight 2.38 lbs./ft. Wall thickness or gauge No. 248  
 TYPE OF SCREEN OR PERFORATION MATERIAL:  
 1 Steel 3 Stainless steel 5 Fiberglass 7 PVC 10 Asbestos-cement  
 2 Brass 4 Galvanized steel 6 Concrete tile 8 RMP (SR) 11 Other (specify) \_\_\_\_\_  
 9 ABS 12 None used (open hole)  
 SCREEN OR PERFORATION OPENINGS ARE:  
 1 Continuous slot 3 Mill slot 5 Gauzed wrapped 8 Saw cut 11 None (open hole)  
 2 Louvered shutter 4 Key punched 6 Wire wrapped 9 Drilled holes  
 7 Torch cut 10 Other (specify) \_\_\_\_\_  
 SCREEN-PERFORATED INTERVALS: From 135 ft. to 175 ft., From \_\_\_\_\_ ft. to \_\_\_\_\_ ft.  
 From \_\_\_\_\_ ft. to \_\_\_\_\_ ft., From \_\_\_\_\_ ft. to \_\_\_\_\_ ft.  
 GRAVEL PACK INTERVALS: From 20 ft. to 175 ft., From \_\_\_\_\_ ft. to \_\_\_\_\_ ft.  
 From \_\_\_\_\_ ft. to \_\_\_\_\_ ft., From \_\_\_\_\_ ft. to \_\_\_\_\_ ft.

6 GROUT MATERIAL: 1 Neat cement 2 Cement grout 3 Bentonite 4 Other \_\_\_\_\_  
 Grout Intervals: From 0 ft. to 20 ft., From \_\_\_\_\_ ft. to \_\_\_\_\_ ft., From \_\_\_\_\_ ft. to \_\_\_\_\_ ft.  
 What is the nearest source of possible contamination:  
 1 Septic tank 4 Lateral lines 7 Pit privy 10 Livestock pens 14 Abandoned water well  
 2 Sewer lines 5 Cess pool 8 Sewage lagoon 11 Fuel storage 15 Oil well/Gas well  
 3 Watertight sewer lines 6 Seepage pit 9 Feedyard 12 Fertilizer storage 16 Other (specify below) \_\_\_\_\_  
 13 Insecticide storage  
 Direction from well? 50 How many feet? NW

FROM	TO	LITHOLOGIC LOG	FROM	TO	PLUGGING INTERVALS
0	3	Surface	164	175	Ochre
3	15	Loess			
15	24	Silty Sand			
24	37	Sandy Clay w/Caliche			
37	48	Cemented Sand			
48	59	Fine Med. Sand w/Cem. Strks.			
59	76	Cemented Sand			
76	84	Fine to Med Sand w/Cem. Strks.			
84	94	Sandy Clay w/Sand Strks.			
94	111	Caliche			
111	131	Fine Med. Sand w/Clay Strks.			
131	139	Sticky Clay w/Sand Strks.			
139	152	Fine Med. Sand			
152	160	Sandy Clay w/Sand Strks.			
160	164	Fine Med. Sand			

7 CONTRACTOR'S OR LANDOWNER'S CERTIFICATION: This water well was (1) constructed, (2) reconstructed, or (3) plugged under my jurisdiction and was completed on (mo/day/year) 4-18-96 and this record is true to the best of my knowledge and belief. Kansas Water Well Contractor's License No. 554. This Water Well Record was completed on (mo/day/yr) 4-19-96 under the business name of Woofter Pump & Well, Inc. by (signature) [Signature]

INSTRUCTIONS: Use typewriter or ball point pen. PLEASE PRESS FIRMLY and PRINT clearly. Please fill in blanks, underline or circle the correct answers. Send top three copies to Kansas Department of Health and Environment, Bureau of Water, Topeka, Kansas 66620-0001. Telephone: 913-296-5545. Send one to WATER WELL OWNER and retain one for your records.