


1 LOCATION OF WATER WELL: Fraction NW 1/4 SE 1/4 NW 1/4 Section Number 6 Township Number T 18 S Range Number R 31 E/W

Distance and direction from nearest town or city street address of well if located within city?  
6 miles east & 2-3/4 north of Scott City, Ks.

2 WATER WELL OWNER: Janzen 1-6 Murfin Drilling  
RR#, St. Address, Box #: Box 661 Board of Agriculture, Division of Water Resources  
City, State, ZIP Code: Colby, Ks. 67701 Application Number: 900243

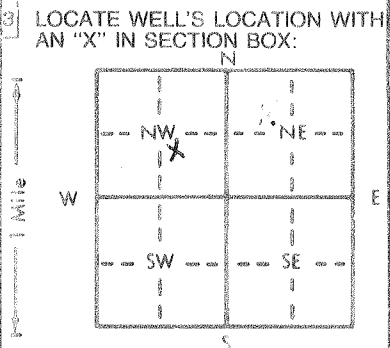

4 DEPTH OF COMPLETED WELL: 167 ft. ELEVATION: ... ft.  
Depth(s) Groundwater Encountered 1. ... ft. 2. ... ft. 3. ... ft.  
WELL'S STATIC WATER LEVEL: 101 ft. below land surface measured on mo/day/yr  
Pump test data: Well water was ... ft. after ... hours pumping ... gpm  
Est. Yield ... gpm: Well water was ... ft. after ... hours pumping ... gpm  
Bore Hole Diameter: 8 in. to 167 ft., and ... in. to ... ft.  
WELL WATER TO BE USED AS:  
5 Public water supply 8 Air conditioning 11 Injection well  
1 Domestic 3 Feedlot 6 Oil field water supply 9 Dewatering 12 Other (Specify below)  
2 Irrigation 4 Industrial 7 Lawn and garden only 10 Monitoring well  
Was a chemical/bacteriological sample submitted to Department? Yes... No... X...; If yes, mo/day/yr sample was submitted  
Water Well Disinfected? Yes No X

5 TYPE OF BLANK CASING USED:  
1 Steel 3 RMP (SR) 5 Wrought iron 8 Concrete tile CASING JOINTS: Glued X Clamped  
2 PVC 4 ABS 6 Asbestos-Cement 9 Other (specify below) Welded  
7 Fiberglass Threaded  
Blank casing diameter: 4.5 in. to 127 ft., Dia. ... in. to ... ft., Dia. ... in. to ... ft.  
Casing height above land surface: 12 in., weight 2.38 lbs./ft. Wall thickness or gauge No. 248  
TYPE OF SCREEN OR PERFORATION MATERIAL:  
1 Steel 3 Stainless steel 5 Fiberglass 8 RMP (SR) 11 Other (specify)  
2 Brass 4 Galvanized steel 6 Concrete tile 9 ABS 12 None used (open hole)  
SCREEN OR PERFORATION OPENINGS ARE:  
1 Continuous slot 3 Mill slot 5 Gauzed wrapped 8 Saw cut 11 None (open hole)  
2 Louvered shutter 4 Key punched 6 Wire wrapped 9 Drilled holes  
7 Torch cut 10 Other (specify)  
SCREEN-PERFORATED INTERVALS: From 127 ft. to 167 ft., From ... ft. to ... ft.  
GRAVEL PACK INTERVALS: From 20 ft. to 167 ft., From ... ft. to ... ft.

6 GROUT MATERIAL: 1 Neat cement 2 Cement grout 3 Bentonite 4 Other  
Grout Intervals: From 0 ft. to 20 ft., From ... ft. to ... ft., From ... ft. to ... ft.  
What is the nearest source of possible contamination:  
1 Septic tank 4 Lateral lines 7 Pit privy 10 Livestock pens 14 Abandoned water well  
2 Sewer lines 5 Cess pool 8 Sewage lagoon 11 Fuel storage 15 Oil well/Gas well  
3 Watertight sewer lines 6 Seepage pit 9 Feedyard 12 Fertilizer storage 16 Other (specify below)  
13 Insecticide storage  
Direction from well? SE How many feet? 80

FROM	TO	LITHOLOGIC LOG	FROM	TO	PLUGGING INTERVALS
0	3	Surface	155	159	Med. sand
3	44	Clay & caliche	159	163	Ochre
44	55	Fine sand	163	167	Shale
55	57	Clay			
57	60	Fine sand			
60	66	Cemented sand & clay			
66	70	Fine sand			
70	71	Clay			
71	76	Med. sand			
76	90	Cemented sand & caliche (hard)			
90	92	Clay			
92	97	Fine sand			
97	99	Clay			
99	135	Fine sand			
135	155	Clay & fine sand			

7 CONTRACTOR'S OR LANDOWNER'S CERTIFICATION: This water well was (1) constructed, (2) reconstructed, or (3) plugged under my jurisdiction and was completed on (mo/day/year) 6-2-90 and this record is true to the best of my knowledge and belief. Kansas Water Well Contractor's License No. 394 This Water Well Record was completed on (mo/day/yr) 6-7-90 under the business name of WOOFER PUMP & WELL by (signature) Walter Woofler