


1 LOCATION OF WATER WELL: County SCOTT Fraction NW 1/4 SW 1/4 NW 1/4 Section Number 20 Township Number T 18 S Range Number R 32 EW

Distance and direction from nearest town or city street address of well if located within city?

221 W. 5th ST  
 WATER WELL OWNER: SCOTT CITY Municipal Air Port  
 RR#, St. Address, Box # 221 W. 5th ST.  
 City, State, ZIP Code SCOTT CITY, KS 67871

Board of Agriculture, Division of Water Resource  
 Application Number:

3 LOCATE WELL'S LOCATION WITH AN "X" IN SECTION BOX: 4 DEPTH OF COMPLETED WELL 125.0 ft. ELEVATION: 2958.24

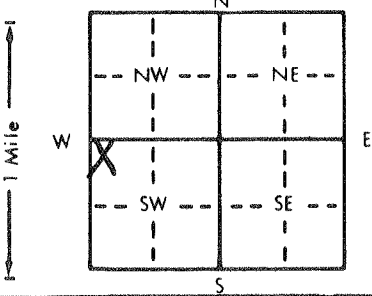

Depth(s) Groundwater Encountered ..... ft. 2. .... ft. 3. .... ft.  
 WELL'S STATIC WATER LEVEL 110.32 ft. below land surface measured on mo/day/yr 10/12/95  
 Pump test data: Well water was ..... ft. after ..... hours pumping ..... gpm  
 Est. Yield ..... gpm Well water was ..... ft. after ..... hours pumping ..... gpm  
 Bore Hole Diameter 8 in. to ..... ft., and ..... in. to ..... ft.  
 WELL WATER TO BE USED AS: 5 Public water supply 8 Air conditioning 11 Injection well  
 1 Domestic 3 Feedlot 6 Oil field water supply 9 Dewatering 12 Other (Specify below)  
 2 Irrigation 4 Industrial 7 Lawn and garden only 10 Monitoring well  
 Was a chemical/bacteriological sample submitted to Department? Yes No; If yes, mo/day/yr sample was submitted  
 Water Well Disinfected? Yes No

5 TYPE OF BLANK CASING USED: 5 Wrought iron 8 Concrete tile CASING JOINTS: Glued ..... Clamped .....  
2 PVC 3 RMP (SR) 6 Asbestos-Cement 9 Other (specify below) Threaded  
 4 ABS 7 Fiberglass  
 Blank casing diameter 4 in. to ..... ft., Dia ..... in. to ..... ft., Dia ..... in. to ..... ft.  
 Casing height above land surface Flush in., weight 2.071 lbs./ft. Wall thickness or gauge No. Sch. 40  
 TYPE OF SCREEN OR PERFORATION MATERIAL: 7 PVC 10 Asbestos-cement  
 1 Steel 3 Stainless steel 5 Fiberglass 8 RMP (SR) 11 Other (specify) .....  
 2 Brass 4 Galvanized steel 6 Concrete tile 9 ABS 12 None used (open hole)  
 SCREEN OR PERFORATION OPENINGS ARE: 5 Gauzed wrapped 8 Saw cut 11 None (open hole)  
 1 Continuous slot 3 Mill slot 6 Wire wrapped 9 Drilled holes  
 2 Louvered shutter 4 Key punched 7 Torch cut 10 Other (specify) .....  
 SCREEN-PERFORATED INTERVALS: From 95.0 ft. to 125.0 ft. From ..... ft. to ..... ft.  
 GRAVEL PACK INTERVALS: From 94.0 ft. to 130.5 ft. From ..... ft. to ..... ft.

6 GROUT MATERIAL: 1 Neat cement 2 Cement grout 3 Bentonite 4 Other .....  
 Grout Intervals: From 3.0 ft. to 94.0 ft. From ..... ft. to ..... ft.  
 What is the nearest source of possible contamination:  
 1 Septic tank 4 Lateral lines 7 Pit privy 11 Fuel storage 14 Abandoned water well  
 2 Sewer lines 5 Cess pool 8 Sewage lagoon 12 Fertilizer storage 15 Oil well/Gas well  
 3 Watertight sewer lines 6 Seepage pit 9 Feedyard 13 Insecticide storage 16 Other (specify below)

Direction from well? 90' NW

FROM	TO	LITHOLOGIC LOG	FROM	TO	PLUGGING INTERVALS
0	29.5	Clay			
29.5	45	Sand			
45	70	Clay			
70	77	Sand			
77	130	Clay			
130	130.5	Sand			

7 CONTRACTOR'S OR LANDOWNER'S CERTIFICATION: This water well was (1) constructed, (2) reconstructed, or (3) plugged under my jurisdiction and was completed on (mo/day/year) 10/12/95 and this record is true to the best of my knowledge and belief. Kansas Water Well Contractor's License No. 531 This Water Well Record was completed on (mo/day/yr) 10/31/95 under the business name of Geotechnical Services, Inc. by (signature) Mark H. R...