


WATER WELL RECORD Form WWC-5 KSA 82a-1212

1 LOCATION OF WATER WELL: Fraction Section Number Township Number Range Number
 COUNTY: 086 SCOTT *Cont. of W side* | *N 1/2 S 1/2* SW 1/4 | 20 | T 18 S | R 32 W

Distance and direction from nearest town or city street address of well if located within city?
 FROM SCOTT CITY ON HWY 83, 1M E, 1/2M N, WELL ON E SIDE.

2 WATER WELL OWNER: BEEF BELT FEEDERS
 RR#, St. Address, Box #: ROUTE 2 Board of Agriculture, Division of Water Resources
 City, State, ZIP code: SCOTT CITY, KS 67871- Application Number: SC-022

3 LOCATE WELL'S LOCATION WITH AN "X" IN SECTION BOX: 4 DEPTH OF COMPLETED WELL 198 ELEVATION: 0
 Depth(s) Groundwater Encountered 1. 0 ft. 2. 0 ft. 3. 0 ft.

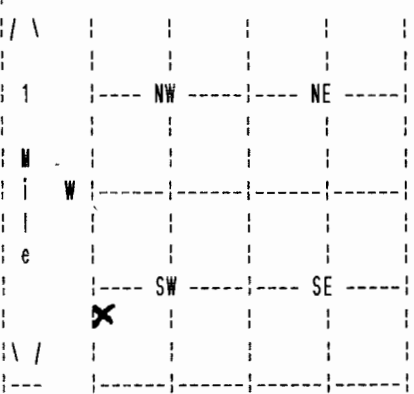

WELL'S STATIC WATER LEVEL: 114 ft. below land surface measured on mo/day/yr 06/14/96
 Pump test data: Well water was 154 ft. after 2 hours pumping 805 gpm
 Estimated Yield 800 gpm: Well water was 0 ft. after 0 hours pumping 0 gpm
 Bore Hole Diameter 24 in. to 198 ft., and in. to 0 ft.
 WELL WATER TO BE USED AS: 02 IRRIGATION
 Was a chemical/bacteriological sample submitted to department? No;
 If yes, mo/day/yr sample was submitted Water well disinfected? Yes

5 TYPE OF BLANK CASING USED: 01 STEEL CASING JOINTS: WELDED
 Blank casing diameter 16 in. to 198 ft., Dia in. to 0 ft., Dia in. to 0 ft.
 Casing height above land surface 12 in., weight 42 lbs/ft. Wall thickness or gauge No. .250
 TYPE OF SCREEN OR PERFORATION MATERIAL: 01 STEEL
 SCREEN OR PERFORATION OPENINGS ARE: 01 CONT. SLOT

SCREEN PERFORATED INTERVALS: From 128 ft. to 188 ft., From 0 ft. to 0 ft.
 From 0 ft. to 0 ft., From 0 ft. to 0 ft.
 GRAVEL PACK INTERVALS: From 20 ft. to 189 ft., From 0 ft. to 0 ft.
 From 0 ft. to 0 ft., From 0 ft. to 0 ft.

6 GROUT MATERIAL 02 - BENTONITE
 Grout Intervals: From 0 ft. to 20 ft., From 0 ft. to 0 ft., From 0 ft. to 0 ft.
 What is the nearest source of possible contamination: 1/4 ABAND. WELL
 Direction from well? SOUTH How many feet? 40

FROM	TO	LITHOLOGIC LOG	FROM	TO	PLUGGING INTERVALS
0	1	02 SILT			
1	33	01 CLAY			
33	43	08 MEDIUM SAND 09 COARSE SAND 11 GRAVEL			
43	54	01 CLAY			
54	82	07 FINE SAND 09 COARSE SAND 11 GRAVEL			
82	90	01 CLAY			
90	109	08 MEDIUM SAND 09 COARSE SAND 11 GRAVEL			
109	121	36 GYP ROCK 01 CLAY			
121	131	08 MEDIUM SAND 09 COARSE SAND 11 GRAVEL			
131	137	36 GYP ROCK 01 CLAY			

7 CONTRACTOR'S OR LANDOWNER'S CERTIFICATION: This water well was Constructed under my jurisdiction and was completed on (mo/day/year) 06/08/96 and this record is true to the best of my knowledge and belief. Kansas Water Well Contractor's License No. 145 This Water Well Record was completed on (mo/day/yr) 06/24/96 under the business name of HENKLE DRILLING & SUPPLY by (signature)

(Continued)

WATER WELL RECORD Form WWC-5 KSA 82a-1212

1 LOCATION OF WATER WELL:	Fraction	Section Number	Township Number	Range Number
COUNTY: 086 SCOTT	1/4 1/4 SW 1/4	20	T 18 S	R 32 W

2 WATER WELL OWNER:	BEEF BELT FEEDERS	Board of Agriculture, Division of Water Resources
RR#, St. Address, Box # :	ROUTE 2	Application Number: SC-022
City, State, ZIP code :	SCOTT CITY, KS 67871-	

FROM	TO	LITHOLOGIC LOG
137	142	08 MEDIUM SAND 09 COARSE SAND 11 GRAVEL
142	157	01 CLAY 36 GYP ROCK
157	171	08 MEDIUM SAND 09 COARSE SAND 11 GRAVEL
171	173	01 CLAY
173	182	08 MEDIUM SAND 09 COARSE SAND 11 GRAVEL
182	185	01 CLAY
185	188	07 FINE SAND 08 MEDIUM SAND
188	198	31 CALICHE

7 CONTRACTOR'S OR LANDOWNER'S CERTIFICATION: This water well was Constructed under my jurisdiction and was completed on (mo/day/year) 06/08/96 and this record is true to the best of my knowledge and belief. Kansas Water Well Contractor's License No. 145 This Water Well Record was completed on (mo/day/yr) 06/24/96 under the business name of HENKLE DRILLING & SUPPLY by (signature)

Ernst Reichmuth