


1 LOCATION OF WATER WELL: County: Scott Fraction: SE 1/4 NW 1/4 SW 1/4 Section Number: 18 Township Number: T 18 S Range Number: R 32 E (11)

Distance and direction from nearest town or city street address of well if located within city?
In-town

2 WATER WELL OWNER: Scott City Cooperative
RR#, St. Address, Box #: 1st & Antelope Board of Agriculture, Division of Water Resources
City, State, ZIP Code: Scott City, Ks. Application Number:

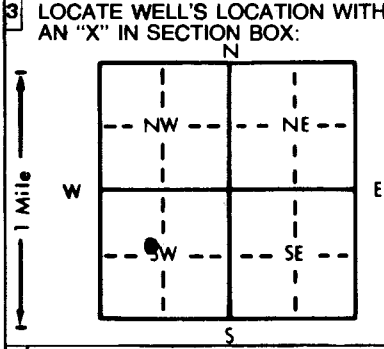

4 DEPTH OF COMPLETED WELL: 220' ft. ELEVATION: ft.
Depth(s) Groundwater Encountered: 134' ft. 2. ft. 3. ft.
WELL'S STATIC WATER LEVEL: 133' ft. below land surface measured on mo/day/yr 8-6-95
Pump test data: Well water was ft. after hours pumping gpm
Est. Yield: 25+ gpm; Well water was ft. after hours pumping gpm
Bore Hole Diameter: 8" in. to 220' ft., and in. to ft.
WELL WATER TO BE USED AS:
5 Public water supply 8 Air conditioning 11 Injection well
1 Domestic 3 Feedlot 6 Oil field water supply 9 Dewatering 12 Other (Specify below)
2 Irrigation 4 Industrial 7 Lawn and garden only 10 Monitoring well
Was a chemical/bacteriological sample submitted to Department? Yes..... No X If yes, mo/day/yr sample was submitted
Water Well Disinfected? Yes No

5 TYPE OF BLANK CASING USED:
1 Steel 3 RMP (SR) 5 Wrought iron 8 Concrete tile CASING JOINTS: Glued Clamped
2 PVC 4 ABS 6 Asbestos-Cement 9 Other (specify below) Welded
7 Fiberglass Threaded X
Blank casing diameter: 4.50 in. to 190' ft., Dia. in. to ft., Dia. in. to ft.
Casing height above land surface: Flush Mt. in., weight lbs./ft. Wall thickness or gauge No. Sch 40
TYPE OF SCREEN OR PERFORATION MATERIAL:
1 Steel 3 Stainless steel 5 Fiberglass 8 RMP (SR) 10 Asbestos-cement
2 Brass 4 Galvanized steel 6 Concrete tile 9 ABS 11 Other (specify)
12 None used (open hole)
SCREEN OR PERFORATION OPENINGS ARE:
1 Continuous slot 3 Mill slot 5 Gauzed wrapped 8 Saw cut 11 None (open hole)
2 Louvered shutter 4 Key punched 6 Wire wrapped 9 Drilled holes
7 Torch cut 10 Other (specify)
SCREEN-PERFORATED INTERVALS: From 220' ft. to 190' ft., From ft. to ft.
GRAVEL PACK INTERVALS: From 220' ft. to 185' ft., From ft. to ft.

6 GROUT MATERIAL: 1 Neat cement 2 Cement grout 3 Bentonite 4 Other
Grout Intervals: From 185' ft. to 3' ft., From 3' ft. to 0' ft., From ft. to ft.
What is the nearest source of possible contamination:
1 Septic tank 4 Lateral lines 7 Pit privy 10 Livestock pens 14 Abandoned water well
2 Sewer lines 5 Cess pool 8 Sewage lagoon 11 Fuel storage 15 Oil well/Gas well
3 Watertight sewer lines 6 Seepage pit 9 Feedyard 12 Fertilizer storage 16 Other (specify below)
13 Insecticide storage
Direction from well? East How many feet? 140'

FROM	TO	LITHOLOGIC LOG	FROM	TO	PLUGGING INTERVALS
0	20	Bn clay, dry to moist, no odor			
20	40	ln-clt Bn clay, moist to dry, no odor			
40	60	ln-clay, sandy clay, moist to dry			
60	65	fine grained sand, dry, no odor			
65	84	ln sandy clay, fine grained, dry, no odor			
84	101	Red Bn sandy clay, dry, firm, no odor			
101	140'	ln clay, sandy clay, fine grained wet at 135'			
140'	157'	ln Bn sandy clay, moist to wet, sand fine-coarse, no odor			
157'	220'	Fine coarse grained sand & gravel, wet sub rounded & sub angular, no odor			

F.M. OK'd by Don Taylor

7 CONTRACTOR'S OR LANDOWNER'S CERTIFICATION: This water well was (1) constructed, (2) reconstructed, or (3) plugged under my jurisdiction and was completed on (mo/day/year) 8-6-96 and this record is true to the best of my knowledge and belief. Kansas Water Well Contractor's License No. 539 This Water Well Record was completed on (mo/day/yr) 8-16-96 under the business name of AB Environmental Drilling by (signature) James Eubel

INSTRUCTIONS: Use typewriter or ball point pen. PLEASE PRESS FIRMLY and PRINT clearly. Please fill in blanks, underline or circle the correct answers. Send top three copies to Kansas Department of Health and Environment, Bureau of Water, Topeka, Kansas 66620-0001. Telephone: 913-296-5545. Send one to WATER WELL OWNER and retain one for your records.