


1 LOCATION OF WATER WELL: Fraction SW 1/4 NE 1/4 SW 1/4 Section Number 28 Township Number T 18 S Range Number R 32 EW
 County: Scott Distance and direction from nearest town or city street address of well if located within city?

1 mile south and 2 east

2 WATER WELL OWNER: Scott Co. RR#, St. Address, Box #: County Clerk Court House Board of Agriculture, Division of Water Resources
 City, State, ZIP Code: Scott City KS 67871 Application Number:

3 LOCATE WELL'S LOCATION WITH AN "X" IN SECTION BOX. 4 DEPTH OF COMPLETED WELL: 105 ft. ELEVATION: 105 ft.
 Depth(s) Groundwater Encountered 1. 96 ft. 2. ft. 3. ft.
 WELL'S STATIC WATER LEVEL 96 ft. below land surface measured on mo/day/yr 10-23-96

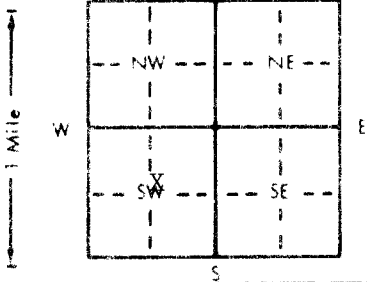

Pump test data: Well water was ft. after hours pumping gpm
 Est. Yield gpm: Well water was ft. after hours pumping gpm
 Bore Hole Diameter: 6.25 in. to 132 ft. and in. to ft.
 WELL WATER TO BE USED AS:
 5 Public water supply 8 Air conditioning 11 Injection well
 1 Domestic 3 Feedlot 6 Oil field water supply 9 Dewatering 12 Other (Specify below)
 2 Irrigation 4 Industrial 7 Lawn and garden only 10 Monitoring well
 Was a chemical/bacteriological sample submitted to Department? Yes No X; If yes, mo/day/yr sample was submitted
 Water Well Disinfected? Yes X No

5 TYPE OF BLANK CASING USED:
 1 Steel 3 RMP (SR) 5 Wrought iron 8 Concrete tile CASING JOINTS: Glued Clamped
 2 PVC 4 ABS 6 Asbestos-Cement 9 Other (specify below) Welded
 7 Fiberglass Threaded X
 Blank casing diameter 2 in. to 85 ft. Dia. in. to ft. Dia. in. to ft.
 Casing height above land surface 36 in. weight lbs. ft. Wall thickness or gauge No. SCH. 40

TYPE OF SCREEN OR PERFORATION MATERIAL:
 1 Steel 3 Stainless steel 5 Fiberglass 7 PVC 10 Asbestos-cement
 2 Brass 4 Galvanized steel 6 Concrete tile 8 RMP (SR) 11 Other (specify)
 9 ABS 12 None used (open hole)

SCREEN OR PERFORATION OPENINGS ARE:
 1 Continuous slot 3 Mill slot 5 Gauzed wrapped 8 Saw cut 11 None (open hole)
 2 Louvered shutter 4 Key punched 6 Wire wrapped 9 Drilled holes
 7 Torch cut 10 Other (specify)

SCREEN-PERFORATED INTERVALS: From 85 ft. to 105 ft. From ft. to ft.
 GRAVEL PACK INTERVALS: From 78 ft. to 132 ft. From ft. to ft.

6 GROUT MATERIAL: 1 Neat cement 2 Cement grout 3 Bentonite 4 Other
 Grout Intervals: From 0 ft. to 3 ft. From 3 ft. to 78 ft. From ft. to ft.
 What is the nearest source of possible contamination:
 1 Septic tank 4 Lateral lines 7 Pit privy 10 Livestock pens 14 Abandoned water well
 2 Sewer lines 5 Cess pool 8 Sewage lagoon 11 Fuel storage 15 Oil well/Gas well
 3 Watertight sewer lines 6 Seepage pit 9 Feedyard 12 Fertilizer storage 16 Other (specify below)
 13 Insecticide storage Landfill
 Direction from well? South How many feet? 100

FROM	TO	LITHOLOGIC LOG	FROM	TO	PLUGGING INTERVALS
0	11	Topsoil and brown clay			
11	29	Cliche			
29	39	Fine sand, gravel and clay			
39	49	Medium sand			
49	65	Cemented sand, cliche and chert			
65	82	Chert and small fine sand streaks			
82	95	Chert and fine sand			
95	96	Fine sand			
96	98	Sandy clay			
98	114	Chert and sandd			
114	120	Chert and white clay			
120	132	Yellow clay			

7 CONTRACTOR'S OR LANDOWNER'S CERTIFICATION: This water well was (1) constructed, (2) reconstructed, or (3) plugged under my jurisdiction and was completed on (mo/day/year) 10-21-96 and this record is true to the best of my knowledge and belief. Kansas
 Water Well Contractor's License No. 473 This Water Well Record was completed on (mo/day/yr) 10-22-96
 under the business name of Tyler Water Well Service Inc. by (signature) *Tyler Water Well Service Inc.*

INSTRUCTIONS: Use typewriter or ball point pen. PLEASE PRESS FIRMLY and PRINT clearly. Please fill in blanks, underline or circle the correct answers. Send top three copies to Kansas Department of Health and Environment, Bureau of Water, Topeka, Kansas 66620-0091. Telephone: 913-296-5545. Send one to WATER WELL OWNER and retain one for your records

OFFICE USE ONLY
 T
 R
 EW
 SEC