


WATER WELL RECORD Form WWC-3 KSA 82a-1212

1 LOCATION OF WATER WELL: County: Scott County	Fraction NE 1/4 NE 1/4 NE 1/4	Section Number 6	Township Number T 18 S	Range Number R 32 E/W
--	--	----------------------------	----------------------------------	---------------------------------

Distance and direction from nearest town or city street address of well if located within city?
3 N 9/10 E

2 WATER WELL OWNER: **Nellie Deeds**
 RR#, St. Address, Box # : **707 Madison**
 City, State, ZIP Code : **Scott City KS 67871**
 Board of Agriculture, Division of Water Resources
 Application Number:

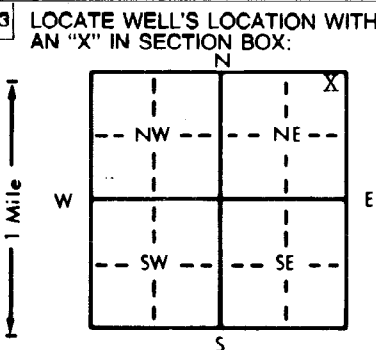

4 DEPTH OF COMPLETED WELL **264** ft. ELEVATION:

Depth(s) Groundwater Encountered 1. **120** ft. 2. ft. 3. ft.

WELL'S STATIC WATER LEVEL **120** ft. below land surface measured on mo/day/yr

Pump test data: Well water was **135** ft. after **1** hours pumping **10** gpm

Est. Yield **25** gpm: Well water was ft. after hours pumping gpm

Bore Hole Diameter **10** in. to ft., and in. to ft.

WELL WATER TO BE USED AS:

5 Public water supply	8 Air conditioning	11 Injection well
1 Domestic	3 Feedlot	6 Oil field water supply
2 Irrigation	4 Industrial	7 Lawn and garden only
		9 Dewatering
		10 Monitoring well
		12 Other (Specify below)

Was a chemical/bacteriological sample submitted to Department? Yes.....No **X**.....; If yes, mo/day/yr sample was submitted

Water Well Disinfected? Yes **X** No

5 TYPE OF BLANK CASING USED:

1 Steel	3 RMP (SR)	5 Wrought iron	8 Concrete tile	CASING JOINTS: Glued X Clamped
2 PVC	4 ABS	6 Asbestos-Cement	9 Other (specify below)	Welded
		7 Fiberglass		Threaded

Blank casing diameter in. to ft., Dia in. to ft., Dia in. to ft.

Casing height above land surface **18** in., weight lbs./ft. Wall thickness or gauge No. **SCH40**

TYPE OF SCREEN OR PERFORATION MATERIAL:

1 Steel	3 Stainless steel	5 Fiberglass	8 RMP (SR)	10 Asbestos-cement
2 Brass	4 Galvanized steel	6 Concrete tile	9 ABS	11 Other (specify)
				12 None used (open hole)

SCREEN OR PERFORATION OPENINGS ARE:

1 Continuous slot	3 Mill slot	5 Gauzed wrapped	8 Saw cut	11 None (open hole)
2 Louvered shutter	4 Key punched	6 Wire wrapped	9 Drilled holes	
		7 Torch cut	10 Other (specify)	

SCREEN-PERFORATED INTERVALS: From **224** ft. to **264** ft., From ft. to ft.

GRAVEL PACK INTERVALS: From **25** ft. to **264** ft., From ft. to ft.

6 GROUT MATERIAL: 1 Neat cement 2 Cement grout 3 Bentonite 4 Other

Grout Intervals: From **5** ft. to **25** ft., From ft. to ft., From ft. to ft.

What is the nearest source of possible contamination:

1 Septic tank	4 Lateral lines	7 Pit privy	10 Livestock pens	14 Abandoned water well
2 Sewer lines	5 Cess pool	8 Sewage lagoon	11 Fuel storage	15 Oil well/Gas well
3 Watertight sewer lines	6 Seepage pit	9 Feedyard	12 Fertilizer storage	16 Other (specify below)
			13 Insecticide storage	

Direction from well? **North** How many feet? **100**

FROM	TO	LITHOLOGIC LOG	FROM	TO	PLUGGING INTERVALS
0	16	Top soil & brown clay	229	246	Sand & Clay streaks
16	32	Brown clay & little sand	246	260	Sand & clay streaks
32	49	Fine sand & cliche	260	262	Clay
49	65	Cliche & sandy clay brown	262	275	Shale
65	82	Sandy clay & little cliche			
82	114	Brown sandy clay			
114	131	Sandy clay & little cliche			
131	147	Sand fine 4' sandy clay			
147	164	Sand fine 5' sandy clay			
164	180	Sand medium			
180	185	Sand medium to course			
185	197	Cliche & sandy clay			
197	213	Cliche & sand medium			
213	220	Sand medium to course			
220	229	Sandy clay			

7 CONTRACTOR'S OR LANDOWNER'S CERTIFICATION: This water well was **(1)** constructed, (2) reconstructed, or (3) plugged under my jurisdiction and was completed on (mo/day/year) **11-06-97** and this record is true to the best of my knowledge and belief. Kansas Water Well Contractor's License No. **473** This Water Well Record was completed on (mo/day/yr) **11-06-97** under the business name of **Tyler Water Well Service Inc** by (signature) *[Signature]*

INSTRUCTIONS: Use typewriter or ball point pen. PLEASE PRESS FIRMLY and PRINT clearly. Please fill in blanks, underline or circle the correct answers. Send top three copies to Kansas Department of Health and Environment, Bureau of Water, Topeka, Kansas 66620-0001. Telephone: 913-296-5545. Send one to WATER WELL OWNER and retain one for your records.