


1 LOCATION OF WATER WELL: County: Scott Fraction: N C 1/4 SE 1/4 NW 1/4 Section Number: 13 Township Number: T 18 S Range Number: R 32 E (W)

Distance and direction from nearest town or city street address of well if located within city?

2 WATER WELL OWNER: Ruth Beckley Wabash Energy 62439
 RR#, St. Address, Box #: Box 594 Board of Agriculture, Division of Water Resources
 City, State, ZIP Code: Scott City, KS Lawrenceville, Ill Application Number: did not receive

3 LOCATE WELL'S LOCATION WITH AN "X" IN SECTION BOX: From state (ch #16013 7-21-98 cashed)

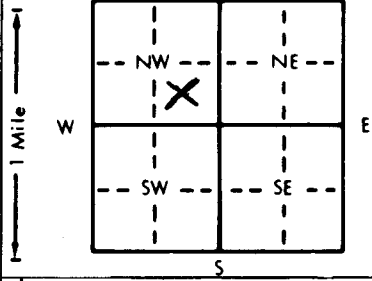

4 DEPTH OF COMPLETED WELL: 165 ft. ELEVATION: 111 ft. below land surface measured on mo/day/yr
 Depth(s) Groundwater Encountered 1. _____ ft. 2. _____ ft. 3. _____ ft.
 WELL'S STATIC WATER LEVEL: 111 ft. below land surface measured on mo/day/yr
 Pump test data: Well water was _____ ft. after _____ hours pumping _____ gpm
 Est. Yield _____ gpm; Well water was _____ ft. after _____ hours pumping _____ gpm
 Bore Hole Diameter: 8 in. to 165 in. to _____ in. to _____ in.
 WELL WATER TO BE USED AS: 5 Public water supply 8 Air conditioning 11 Injection well
 1 Domestic 3 Feedlot 6 Oil field water supply 9 Dewatering 12 Other (Specify below)
 2 Irrigation 4 Industrial 7 Lawn and garden only 10 Monitoring well
 Was a chemical/bacteriological sample submitted to Department? Yes _____ No X; If yes, mo/day/yr sample was submitted
 Water Well Disinfected? Yes _____ No X

5 TYPE OF CASING USED: 1 Steel 3 RMP (SR) 5 Wrought iron 8 Concrete tile CASING JOINTS: Glued X Clamped _____
 2 PVC 4 ABS 6 Asbestos-Cement 9 Other (specify below) Welded _____
 7 Fiberglass Threaded _____
 Blank casing diameter: 4.5 in. to 18 in. Dia. _____ in. to _____ in. Dia. _____ in. to 248 in. Dia. _____ in. to _____ in. Dia. _____
 Casing height above land surface: 18 in. weight 2.38 lbs./ft. Wall thickness or gauge No. _____

TYPE OF SCREEN OR PERFORATION MATERIAL: 7 PVC 10 Asbestos-cement
 1 Steel 3 Stainless steel 5 Fiberglass 8 RMP (SR) 11 Other (specify) _____
 2 Brass 4 Galvanized steel 6 Concrete tile 9 ABS 12 None used (open hole)

SCREEN OR PERFORATION OPENINGS ARE: 5 Gauzed wrapped 8 Saw cut 11 None (open hole)
 1 Continuous slot 3 Mill slot 6 Wire wrapped 9 Drilled holes
 2 Louvered shutter 4 Key punched 7 Torch cut 10 Other (specify) _____

SCREEN-PERFORATED INTERVALS: From 125 ft. to 165 ft. From _____ ft. to _____ ft.
 From _____ ft. to _____ ft. From _____ ft. to _____ ft.
 GRAVEL PACK INTERVALS: From 20 ft. to 165 ft. From _____ ft. to _____ ft.
 From _____ ft. to _____ ft. From _____ ft. to _____ ft.

6 GROUT MATERIAL: 1 Neat cement 2 Cement grout 3 Bentonite 4 Other _____
 Grout intervals: From 20 ft. to 0 ft. From _____ ft. to _____ ft. From _____ ft. to _____ ft.

What is the nearest source of possible contamination:
 1 Septic tank 4 Lateral lines 7 Pit privy 10 Livestock pens 14 Abandoned water well
 2 Sewer lines 5 Cess pool 8 Sewage lagoon 11 Fuel storage 15 Oil well/Gas well
 3 Watertight sewer lines 6 Seepage pit 9 Feedyard 12 Fertilizer storage 16 Other (specify below)
 13 Insecticide storage

Direction from well? _____ How many feet? _____

FROM	TO	LITHOLOGIC LOG	FROM	TO	PLUGGING INTERVALS
0	2	Surface	108	127	Med sand w/ clay
2	10	Loess	127	138	Fine to med sand w/ clay stks
10	20	Clay & caliche	138	147	Sandy clay w/ some sand
20	35	Caliche & clay	147	157	Med sand w/ clay stks fairly loose
35	42	Caliche & cemented sand	157	162	Orkra
42	49	Med sand loose	162	165	Grey & black shale
49	62	Cemented sand w/ med sand stks			
62	67	Med sand & gravel w/ cemented stk			
67	70	Cemented sand			
70	82	Med & gravel w/ some cement			
82	84	Cemented sand hard			
84	93	Caliche & cemented sand			
93	99	Hard caliche			
99	106	Med sand & gravelw/ clay lenses loose			
106	108	Sandy clay			

7 CONTRACTOR'S OR LANDOWNER'S CERTIFICATION: This water well was (1) constructed, (2) reconstructed, or (3) plugged under my jurisdiction and was completed on (mo/day/year) 7-20-98 and this record is true to the best of my knowledge and belief. Kansas Water Well Contractor's License No. 554 This Water Well Record was completed on (mo/day/yr) 10-1-98 under the business name of Woolter Pumps Well, Inc. by (signature) July D. W...