


1 LOCATION OF WATER WELL: Fraction SW 1/4 NW 1/4 NE 1/4 Section Number 19 Township Number T 18 S Range Number R 32 E(W)

Distance and direction from nearest town or city street address of well if located within city?
City well #7, South Oak St., Scott City, Ks.

2 WATER WELL OWNER: **City of Scott City**
 RR#, St. Address, Box #: **211 W. 5th** Board of Agriculture, Division of Water Resources
 City, State, ZIP Code: **Scott City, Ks. 67871** Application Number: **12317**

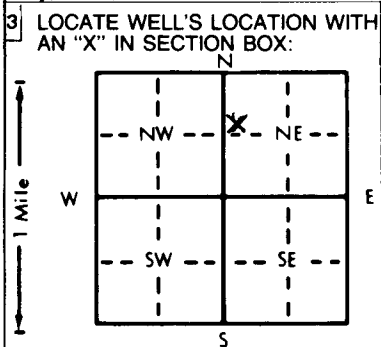

4 DEPTH OF COMPLETED WELL: **214** ft. ELEVATION:
 Depth(s) Groundwater Encountered 1. ft. 2. ft. 3. ft.
 WELL'S STATIC WATER LEVEL: **120** ft. below land surface measured on mo/day/yr **12-8-98**
 Pump test data: Well water was ft. after hours pumping gpm
 Est. Yield gpm: Well water was ft. after hours pumping gpm
 Bore Hole Diameter in. to ft., and in. to ft.
 WELL WATER ~~XXXX~~ USED AS: Public water supply 8 Air conditioning 11 Injection well
 1 Domestic 3 Feedlot 6 Oil field water supply 9 Dewatering 12 Other (Specify below)
 2 Irrigation 4 Industrial 7 Lawn and garden only 10 Monitoring well
 Was a chemical/bacteriological sample submitted to Department? Yes No ; If yes, mo/day/yr sample was submitted
 Water Well Disinfected? Yes No

5 TYPE OF BLANK CASING USED:
 Steel 3 RMP (SR) 5 Wrought iron 8 Concrete tile CASING JOINTS: Glued Clamped
 2 PVC 4 ABS 6 Asbestos-Cement 9 Other (specify below) Welded
 7 Fiberglass Threaded
 Blank casing diameter **14"** in. to ft., Dia. in. to ft., Dia. in. to ft.
 Casing height above land surface **3' below** in., weight lbs./ft. Wall thickness or gauge No.
 TYPE OF SCREEN OR PERFORATION MATERIAL:
 1 Steel 3 Stainless steel 5 Fiberglass 7 PVC 10 Asbestos-cement
 2 Brass 4 Galvanized steel 6 Concrete tile 8 RMP (SR) 11 Other (specify) **NA**
 9 ABS 12 None used (open hole)
 SCREEN OR PERFORATION OPENINGS ARE:
 1 Continuous slot 3 Mill slot 5 Gauzed wrapped 8 Saw cut 11 None (open hole)
 2 Louvered shutter 4 Key punched **999** 6 Wire wrapped 9 Drilled holes
 7 Torch cut **999** 10 Other (specify) **NA**
 SCREEN-PERFORATED INTERVALS: From ft. to ft., From ft. to ft.
 From ft. to ft., From ft. to ft.
 GRAVEL PACK INTERVALS: From ft. to ft., From ft. to ft.
 From ft. to ft., From ft. to ft.

6 GROUT MATERIAL: 1 Neat cement 2 Cement grout Bentonite **chips** Other
 Grout Intervals: From **1** ft. to **11** ft., From ft. to ft., From ft. to ft.
 What is the nearest source of possible contamination: **none**
 1 Septic tank 4 Lateral lines 7 Pit privy 10 Livestock pens 14 Abandoned water well
 2 Sewer lines 5 Cess pool 8 Sewage lagoon 11 Fuel storage 15 Oil well/Gas well
 3 Watertight sewer lines 6 Seepage pit 9 Feedyard 12 Fertilizer storage 16 Other (specify below)
 13 Insecticide storage
 Direction from well? How many feet?

| FROM | TO | LITHOLOGIC LOG | FROM | TO | PLUGGING INTERVALS |
|------|----|----------------|------|-----|----------------------------------|
| | | | 100 | 214 | 4-1/2 yds. washed sand & gravel |
| | | | 11 | 100 | 3-1/2 yds. fill sand & bentonite |
| | | | 1 | 11 | 450 lbs. bentonite chips |
| | | | 0 | 1 | Concrete |

7 CONTRACTOR'S OR LANDOWNER'S CERTIFICATION: This water well was (1) constructed, (2) reconstructed, or plugged under my jurisdiction and was completed on (mo/day/year) **12-8-98** and this record is true to the best of my knowledge and belief. Kansas Water Well Contractor's License No. **532** This Water Well Record was completed on (mo/day/yr) **12-14-98** under the business name of **Midwest Well & Pump Inc** by (signature) *Victor Seakup*