


|                      |                                  |                |                 |              |
|----------------------|----------------------------------|----------------|-----------------|--------------|
| 1                    | LOCATION OF WATER WELL: Fraction | Section Number | Township Number | Range Number |
| County: <b>Scott</b> | <b>NW 1/4 SW 1/4 NW 1/4</b>      | <b>20</b>      | <b>18</b>       | <b>32 W</b>  |

Distance and direction from nearest town or city street address of well if located within city?  
**221 W. 5<sup>th</sup> St.**

2 WATER WELL OWNER: **Scott City Municipal Airport**  
 RR#, St. Address, Box # **221 W. 5<sup>th</sup> St.**  
 City, State, ZIP Code : **Scott City, KS 67871**  
 Board of Agriculture, Division of Water Resources  
 Application Number:

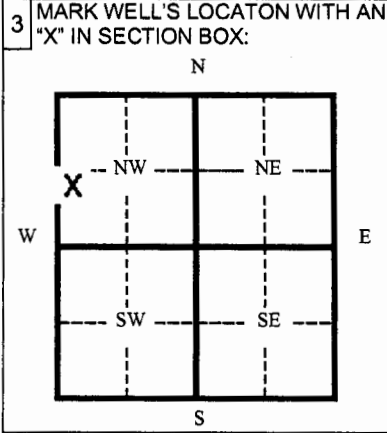

4 DEPTH OF WELL **125.62** ft.  
 WELL'S STATIC WATER LEVEL **119.75** ft.  
 WELL WAS USED AS:  
 1 Domestic                      5 Public Water Supply                      9 Dewatering  
 2 Irrigation                      6 Oil Field Water Supply                      **10 Monitoring Well**  
 3 Feedlot                          7 Lawn and Garden (domestic)                      11 Injection Well  
 4 Industrial                      8 Air Conditioning                          12 Other \_\_\_\_\_  
 Was a chemical/bacteriological sample submitted to Department? Yes \_\_\_\_\_ No **X**  
 If yes, mo/day/yr sample was submitted \_\_\_\_\_  
 Water Well Disinfected: Yes \_\_\_\_\_ No **X**

5 TYPE OF BLANK CASING USED:  
 1 Steel                      3 RMP (SR)                      5 Wrought                      7 Fiberglass                      9 Other (specify below)  
**2 PVC**                      4 ABC                      6 Asbestos-Cement                      8 Concrete Tile  
 Blank casing diameter **4** in. Was casing pulled? Yes \_\_\_\_\_ No **X** If yes, how much \_\_\_\_\_  
 Casing height above or **below** land surface **36** in. **Overdrill to 3 feet below the ground surface**

6 GROUT PLUG MATERIAL: **1 Neat cement**    2 Cement grout    3 Bentonite    4 Other \_\_\_\_\_  
 Grout Plug Intervals From **36** ft. to **125.62** ft. From \_\_\_\_\_ ft. to \_\_\_\_\_ ft. From \_\_\_\_\_ ft. to \_\_\_\_\_ ft.  
 What is the nearest source of possible contamination:  
 1 Septic tank                      6 Seepage pit                      11 Fuel storage                      16 Other (specify below)  
 2 Sewer lines                      7 Pit privy                      12 Fertilizer storage  
 3 Watertight sewer lines                      8 Sewage lagoon                      13 Insecticide storage  
 4 Lateral lines                      9 Feedyard                      14 Abandoned water well  
 5 Cess Pool                      10 Livestock pens                      15 Oil well/ Gas well  
 Direction from well? \_\_\_\_\_ How many feet? \_\_\_\_\_

| FROM | TO     | CODE | PLUGGING MATERIALS        |
|------|--------|------|---------------------------|
| 0    | 125.62 |      | Flowable concrete 750 psi |
|      |        |      |                           |
|      |        |      |                           |
RECEIVED  
 SEP 13 2004  
 BUREAU OF WATER

7 CONTRACTOR'S OR LANDOWNER'S CERTIFICATION: This water well was plugged under my jurisdiction and was completed on (mo/day/yr) **8-12-04** and this record is true to the best of my knowledge and belief. Kansas Water Well Contractor's License No. **531** This Water Well Record was completed on (mo/day/yr) **9-3-04** under the business name of **Geotechnical Services, Inc.** by (signature) *Allison M. [Signature]*

INSTRUCTIONS: Please fill in blanks and circle the correct answers. Send three copies to Kansas Department of Health and Environment, Bureau of Water, 1000 S W Jackson St., Ste. 420, Topeka, Kansas 66620-0001. Telephone: 785-296-3565. Send one to Water Well Owner and retain one for your records.