


| | | | | |
|----------------------|----------------------------------|----------------|-----------------|--------------|
| 1 | LOCATION OF WATER WELL: Fraction | Section Number | Township Number | Range Number |
| County: Scott | NW 1/4 SW 1/4 NW 1/4 | 20 | 18 | 32 W |

Distance and direction from nearest town or city street address of well if located within city?
221 W. 5th St.

2 WATER WELL OWNER: **Scott City Municipal Airport**
 RR#, St. Address, Box # **221 W. 5th St.**
 City, State, ZIP Code : **Scott City, KS 67871**
 Board of Agriculture, Division of Water Resources
 Application Number:

3 MARK WELL'S LOCATON WITH AN "X" IN SECTION BOX:

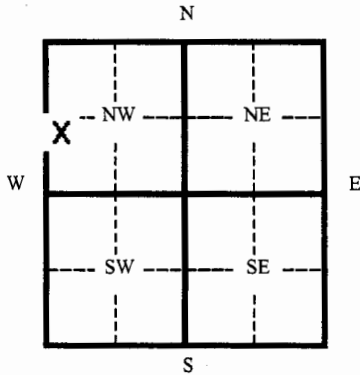

4 DEPTH OF WELL **125.2** ft.

WELL'S STATIC WATER LEVEL **119.10** ft.

WELL WAS USED AS:

- | | | |
|--------------|------------------------------|---------------------------|
| 1 Domestic | 5 Public Water Supply | 9 Dewatering |
| 2 Irrigation | 6 Oil Field Water Supply | 10 Monitoring Well |
| 3 Feedlot | 7 Lawn and Garden (domestic) | 11 Injection Well |
| 4 Industrial | 8 Air Conditioning | 12 Other |

Was a chemical/bacteriological sample submitted to Department? Yes ___ No **X**

If yes, mo/day/yr sample was submitted _____

Water Well Disinfected: Yes ___ No **X**

5 TYPE OF BLANK CASING USED:

- | | | | | |
|--------------|------------|-------------------|-----------------|-------------------------|
| 1 Steel | 3 RMP (SR) | 5 Wrought | 7 Fiberglass | 9 Other (specify below) |
| 2 PVC | 4 ABC | 6 Asbestos-Cement | 8 Concrete Tile | |

Blank casing diameter **4** in. Was casing pulled? Yes ___ No **X** If yes, how much _____

Casing height above or **below** land surface **36** in. **Overdrill to 3 feet below the ground surface**

6 GROUT PLUG MATERIAL: **1 Neat cement** 2 Cement grout 3 Bentonite 4 Other _____

Grout Plug Intervals From **36** ft. to **125.2** ft. From _____ ft. to _____ ft. From _____ ft. to _____ ft.

What is the nearest source of possible contamination:

- | | | | |
|--------------------------|-------------------|-------------------------|--------------------------|
| 1 Septic tank | 6 Seepage pit | 11 Fuel storage | 16 Other (specify below) |
| 2 Sewer lines | 7 Pit privy | 12 Fertilizer storage | |
| 3 Watertight sewer lines | 8 Sewage lagoon | 13 Insecticide storage | |
| 4 Lateral lines | 9 Feedyard | 14 Abandoned water well | |
| 5 Cess Pool | 10 Livestock pens | 15 Oil well/ Gas well | |

Direction from well? _____ How many feet? _____

| FROM | TO | CODE | PLUGGING MATERIALS |
|----------|--------------|------|----------------------------------|
| 0 | 125.2 | | Flowable concrete 750 psi |
| | | | |
| | | | |
| | | | |
| | | | |
| | | | |

RECEIVED
 SEP 13 2004
 BUREAU OF WATER

7 CONTRACTOR'S OR LANDOWNER'S CERTIFICATION: This water well was plugged under my jurisdiction and was completed on (mo/day/yr) **8-12-04** and this record is true to the best of my knowledge and belief. Kansas Water Well Contractor's License No. **531** This Water Well Record was completed on (mo/day/yr) **9-3-04** under the business name of **Geotechnical Services, Inc.** by (signature) *[Signature]*

INSTRUCTIONS: Please fill in blanks and circle the correct answers. Send three copies to Kansas Department of Health and Environment, Bureau of Water, 1000 S W Jackson St., Ste. 420, Topeka, Kansas 66620-0001. Telephone: 785-296-3565. Send one to Water Well Owner and retain one for your records.