

CORRECTION(S) TO WATER WELL RECORD (WWC-5)

(to rectify lacking or incorrect information)

County: Scott

Location listed as:

Location changed to:

Section-Township-Range: 18-185-32W

18-185-32W

Fraction ($\frac{1}{4}$ $\frac{1}{4}$ $\frac{1}{4}$): None Given

NW SW SW

Other changes: Initial statements: _____

Changed to: _____

Comments: _____

verification method: Well address, attached map, city street map on internet, and Scott City 1:24,000 topo. map.


initials: DRL date: 10/12/2005

submitted by: Kansas Geological Survey, Data Resources Library, 1930 Constant Ave., Lawrence, KS 66047-3726
to: Kansas Dept of Health & Environment, Bureau of Water, 1000 SW Jackson, Suite 420, Topeka, KS 66612-1367.

1 LOCATION OF WATER WELL: County: Scott Fraction $\frac{1}{4}$ $\frac{1}{4}$ $\frac{1}{4}$ Section Number 18 Township Number T 18 S Range Number R 32 EW (1)

Distance and direction from nearest town or city street address of well if located within city?
222 South Main Street, Scott City, KS 67871

2 WATER WELL OWNER: Robinson Oil Inc
 RR#, St. Address, Box #: 1718 E Pawnee Road
 City, State, ZIP Code: Garden City, Kansas 67846
 Board of Agriculture, Division of Water Resources
 Application Number:

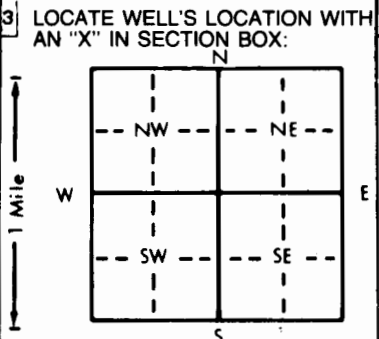

4 DEPTH OF COMPLETED WELL: 155 ft. ELEVATION:
 Depth(s) Groundwater Encountered 1. 145 ft. 2. ft. 3. ft.
 WELL'S STATIC WATER LEVEL: 145 ft. below land surface measured on mo/day/yr 7-9-05
 Pump test data: Well water was ft. after hours pumping gpm
 Est. Yield gpm: Well water was ft. after hours pumping gpm
 Bore Hole Diameter: 8 in. to 155 ft., and in. to ft.
 WELL WATER TO BE USED AS:
 5 Public water supply 8 Air conditioning 11 Injection well
 1 Domestic 3 Feedlot 6 Oil field water supply 9 Dewatering 12 Other (Specify below)
 2 Irrigation 4 Industrial 7 Lawn and garden only 10 Monitoring well
 Was a chemical/bacteriological sample submitted to Department? Yes No; If yes, mo/day/yr sample was submitted
 Water Well Disinfected? Yes No


5 TYPE OF BLANK CASING USED:
 1 Steel 3 RMP (SR) 5 Wrought iron 8 Concrete tile CASING JOINTS: Glued Clamped
2 PVC 4 ABS 6 Asbestos-Cement 9 Other (specify below) Welded
 7 Fiberglass Threaded
 Blank casing diameter 4 in. to 135 ft., Dia. in. to ft., Dia. in. to ft.
 Casing height above land surface 0 in., weight 2.006 lbs./ft. Wall thickness or gauge No. 237
 TYPE OF SCREEN OR PERFORATION MATERIAL:
 1 Steel 3 Stainless steel 5 Fiberglass 8 RMP (SR) 10 Asbestos-cement
 2 Brass 4 Galvanized steel 6 Concrete tile 9 ABS 11 Other (specify)
 12 None used (open hole)
 SCREEN OR PERFORATION OPENINGS ARE:
 1 Continuous slot 3 Mill slot 5 Gauzed wrapped 8 Saw cut 11 None (open hole)
 2 Louvered shutter 4 Key punched 6 Wire wrapped 9 Drilled holes
 7 Torch cut 10 Other (specify)
 SCREEN-PERFORATED INTERVALS: From 135 ft. to 155 ft. From ft. to ft.
 From ft. to ft. From ft. to ft.
 GRAVEL PACK INTERVALS: From 130 ft. to 155 ft. From ft. to ft.
 From ft. to ft. From ft. to ft.

6 GROUT MATERIAL: 1 Neat cement 2 Cement grout 3 Bentonite 4 Other
 Grout Intervals: From 0 ft. to 130 ft. From ft. to ft. From ft. to ft.
 What is the nearest source of possible contamination:
 1 Septic tank 4 Lateral lines 7 Pit privy 10 Livestock pens 14 Abandoned water well
 2 Sewer lines 5 Cess pool 8 Sewage lagoon 11 Fuel storage 15 Oil well/Gas well
 3 Watertight sewer lines 6 Seepage pit 9 Feedyard 12 Fertilizer storage 16 Other (specify below)
 13 Insecticide storage
 Direction from well? How many feet?

FROM	TO	LITHOLOGIC LOG	FROM	TO	PLUGGING INTERVALS
0	30	Brown Silty Sand			
30	45	Brown Clay			
45	65	Brown Sand			
65	145	Brown Clay			
145	155	Brown Sand			
AW-27					

7 CONTRACTOR'S OR LANDOWNER'S CERTIFICATION: This water well was (1) constructed, (2) reconstructed, or (3) plugged under my jurisdiction and was completed on (mo/day/year) 7-8-05 and this record is true to the best of my knowledge and belief. Kansas Water Well Contractor's License No. 658 This Water Well Record was completed on (mo/day/yr) 9-20-05 under the business name of Boast Longyear by (signature) _____

Scott County
272 South Main

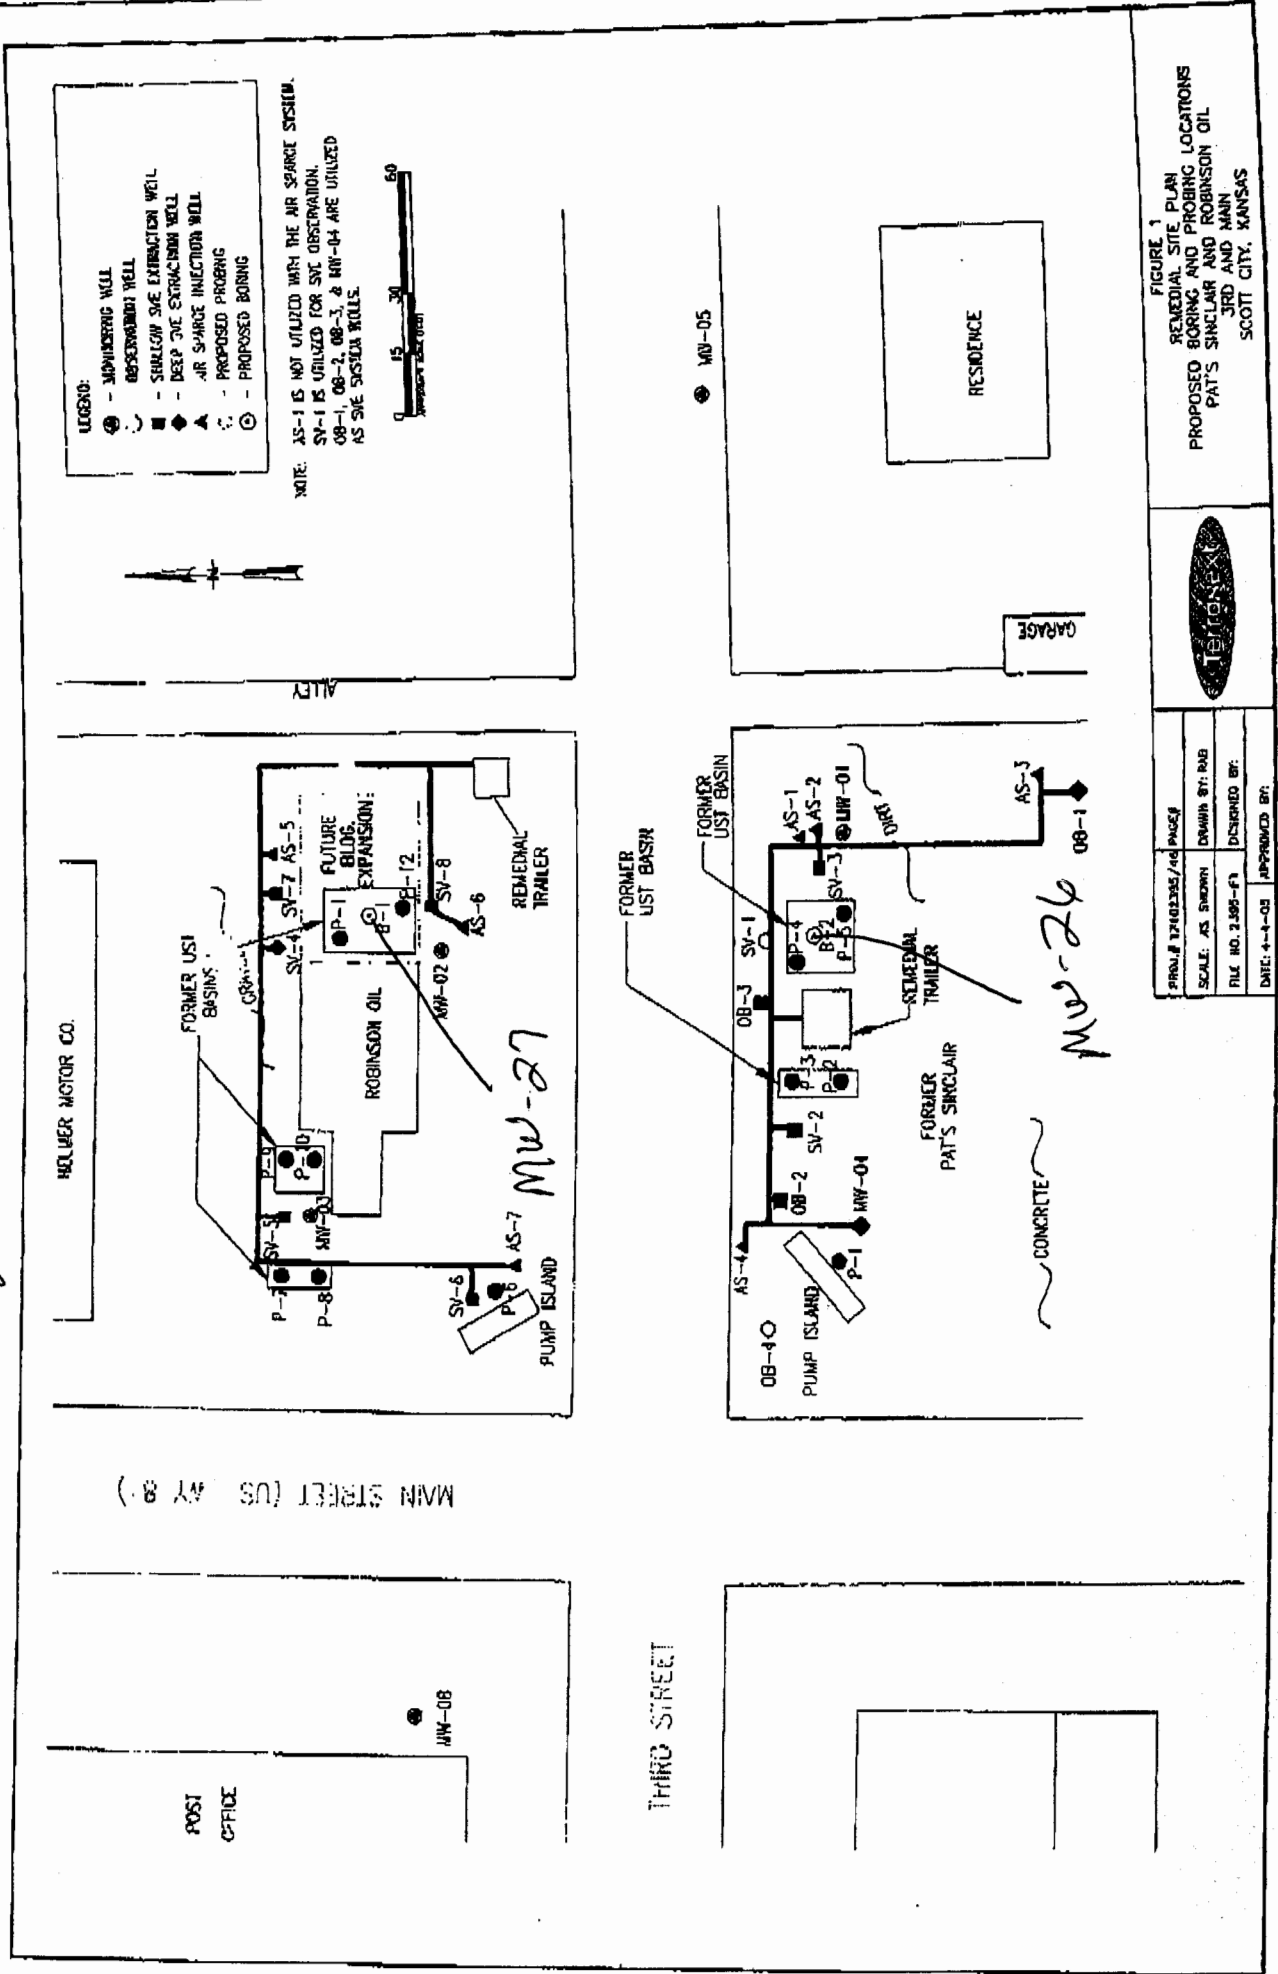

- LEGEND:
- - MONITORING WELL
 - - OBSERVATION WELL
 - - SHALLOW SVE EXTRACTION WELL
 - ◆ - DEEP SVE EXTRACTION WELL
 - ▲ - AIR SPARGE INJECTION WELL
 - (with dot) - PROPOSED PROBING
 - (with cross) - PROPOSED BORING

NOTE: AS-1 IS NOT UTILIZED WITH THE AIR SPARGE SYSTEM.
 SV-1 IS UTILIZED FOR SVE OBSERVATION.
 OB-1, OB-2, OB-3, & MW-04 ARE UTILIZED AS SVE SYSTEM WELLS.



FIGURE 1
 REMEDIAL SITE PLAN
 PROPOSED BORING AND PROBING LOCATIONS
 PAT'S SINCLAIR AND ROBINSON OIL
 3RD AND MAIN
 SCOTT CITY, KANSAS



PROJECT NUMBER/DATE	SCALE	DRAWN BY	DESIGNED BY	DATE	APPROVED BY
	AS SHOWN	RAE		4-4-05	
	FILE NO. 2,896-F3				

MAIN STREET (US HW 8)

THIRD STREET

MW-26

MW-27

CONCRETE