

USE TYPEWRITER OR BALL POINT PEN—PRESS FIRMLY, PRINT CLEARLY.

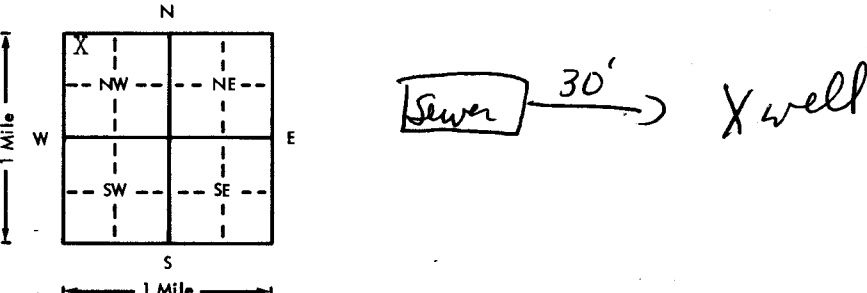
SCOTT CITY

1832W19BBB

WATER WELL RECORD
KSA 82a-1201-1215

BBB

Kansas Department of Health and Environment—Division of Environment
(Water well Contractors)
Topeka, Kansas 66620

1. Location of well:		County Scott	Fraction NW 1/4 NW 1/4 NW 1/4	Section number 19	Township number T 18 S R 32 E	Range number W
2. Distance and direction from nearest town or city: Street address of well location if in city: Scott City, KS				3. Owner of well: Wesley Pitman R.R. or street: 210 E. 6th City, state, zip code: Scott City, KS 67871		
4. Locate with "X" in section below: Sketch map: 				6. Bore hole dia. <u>9</u> in. Completion date _____ Well depth <u>210</u> ft. <u>10-30-75</u>		
5. Type and color of material				7. <input checked="" type="checkbox"/> Cable tool <input checked="" type="checkbox"/> Rotary <input type="checkbox"/> Driven <input type="checkbox"/> Dug <input type="checkbox"/> Hollow rod <input type="checkbox"/> Jetted <input type="checkbox"/> Bored <input type="checkbox"/> Reverse rotary		
				8. Use: <input checked="" type="checkbox"/> Domestic <input type="checkbox"/> Public supply <input type="checkbox"/> Industry <input type="checkbox"/> Irrigation <input type="checkbox"/> Air conditioning <input type="checkbox"/> Stock <input type="checkbox"/> Lawn <input type="checkbox"/> Oil field water <input type="checkbox"/> Other		
				9. Casing: Material <u>Plas.</u> Height: <u>(Above)</u> or below Threaded <input type="checkbox"/> Welded <u>Glue</u> Surface <u>12</u> in. RMP <input checked="" type="checkbox"/> PVC <input type="checkbox"/> Weight <u>1.8</u> lbs./ft. Dia. <u>5</u> in. to <u>190</u> ft. depth Wall Thickness: inches or Dia. _____ in. to _____ ft. depth Gauge No. <u>250</u>		
				10. Screen: Manufacturer's name <u>Jess & Lowell</u> Type <u>RMP</u> Dia. <u>5 in.</u> <u>60</u> gauze <u>1/16</u> Length <u>20 ft.</u> Set between <u>190</u> ft. and <u>210</u> ft. _____ ft. and _____ ft. Gravel pack? <u>Yes</u> Size range of material <u>1/2-1/8</u>		
				11. Static water level: _____ mo./day/yr. <u>102</u> ft. below land surface Date <u>10-30-75</u>		
				12. Pumping level below land surfaces: <u>112</u> ft. after <u>1</u> hrs. pumping <u>18</u> g.p.m. _____ ft. after _____ hrs. pumping _____ g.p.m. Estimated maximum yield <u>18</u> g.p.m.		
				13. Water sample submitted: _____ mo./day/yr. Yes <input checked="" type="checkbox"/> No <input type="checkbox"/> Date _____		
				14. Well head completion: <input checked="" type="checkbox"/> Pitless adapter _____ inches above grade		
				15. Well grouted? <u>Yes</u> With: <input checked="" type="checkbox"/> Neat cement <input type="checkbox"/> Bentonite <input type="checkbox"/> Concrete Depth: From _____ ft. to <u>15</u> ft.		
				16. Nearest source of possible contamination: ft. <u>30</u> Direction <u>W</u> Type <u>Sewer</u> Well disinfected upon completion? <input checked="" type="checkbox"/> Yes <input type="checkbox"/> No		
				17. Pump: Not installed Manufacturer's name <u>Red Jacket</u> Model number <u>150T1</u> HP <u>1 1/2</u> Volts <u>230</u> Length of drop pipe <u>168</u> ft. capacity <u>18</u> g.p.m. Type: <input checked="" type="checkbox"/> Submersible <input type="checkbox"/> Turbine <input type="checkbox"/> Jet <input type="checkbox"/> Reciprocating <input type="checkbox"/> Centrifugal <input type="checkbox"/> Other		
18. Elevation:		19. Remarks:		20. Water well contractor's certification: This well was drilled under my jurisdiction and this report is true to the best of my knowledge and belief. <u>Weishaar Drilling</u> <u>232</u> Business name <u>Scott City, KS 67871</u> License No. _____ Address _____ Signature <u>[Signature]</u> Date <u>11-20-75</u> Authorized representative		
Topography: <input type="checkbox"/> Hill <input type="checkbox"/> Slope <input checked="" type="checkbox"/> Upland <input type="checkbox"/> Valley		<u>Sd coarse</u> <u>Sd rock</u> <u>Sd</u> <u>Yellow</u> <u>BROCK 209'</u>				

1832W19BBB

Forward the white, blue and pink copies to the Department of Health and Environment

Form WWC-5

2975 (TOPO)