

USE TYPEWRITER OR BALL POINT PEN - PRESS FIRMLY, PRINT CLEARLY.

SCOTT CITY

18 32 W18 ACB

33


WATER WELL RECORD  
KSA 82a-1201-1215

Kansas Department of Health and Environment - Division of Environment  
(Water well Contractors)  
Topeka, Kansas 66620

ACB

1. Location of well: County Scott Fraction NW 1/4 SW 1/4 NE 1/4 Section number 18 Township number T 32 S Range number R 32 E/W

2. Distance and direction from nearest town or city: 2 1/2 miles South 1 1/2 miles East of Scott City, Kansas  
Street address of well location if in city: \_\_\_\_\_  
3. Owner of well: B. H. Kimball  
R.R. or street: \_\_\_\_\_  
City, state, zip code: Scott City, Kansas

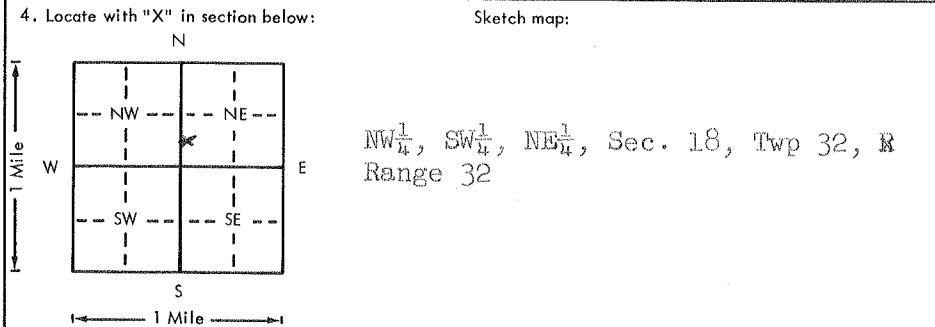

6. Bore hole dia. 30 in. Completion date 11-4-76  
Well depth 108 ft.

7.  Cable tool  Rotary  Driven  Dug  
 Hollow rod  Jetted  Bored  Reverse rotary

8. Use:  Domestic  Public supply  Industry  
 Irrigation  Air conditioning  Stock  
 Lawn  Oil field water  Other

9. Casing: Material steel Height: Above or below  
Threaded  Welded  Surface 12 in.  
RMP  PVC  Weight 36 lbs./ft.  
Dia. 16 in. to 108 ft. depth Wall Thickness: inches or  
Dia. 16 in. to 108 ft. depth gage No. .219

5. Type and color of material	From	To
clay	0	51
medium sand very loose light clay streaks	51	58
clay	58	75
medium sand dirty	75	77
clay	77	89
medium to good loose clean	89	101
rock and clay	101	108
(Use a second sheet if needed)		

10. Screen: Manufacturer's name W. A. Brown Enterprises  
Type steel Dia. 16"  
Slot/gauze 2" Length \_\_\_\_\_  
Set between 48 ft. and 108 ft.  
\_\_\_\_\_ ft. and \_\_\_\_\_ ft.  
Gravel pack?  yes Size range of material 3/8

11. Static water level: \_\_\_\_\_ mo./day/yr.  
57 ft. below land surface Date 11-11-76

12. Pumping level below land surfaces:  
94 ft. after 5 hrs. pumping 650 g.p.m.  
\_\_\_\_\_ ft. after \_\_\_\_\_ hrs. pumping \_\_\_\_\_ g.p.m.  
Estimated maximum yield 650 g.p.m.

13. Water sample submitted: \_\_\_\_\_ mo./day/yr.  
 Yes  No Date \_\_\_\_\_

14. Well head completion:  
 Pitless adapter 12" Inches above grade

15. Well grouted?  yes  
With:  Neat cement  Bentonite  Concrete  
Depth: From 0 ft. to 10 ft.

16. Nearest source of possible contamination: none  
ft. \_\_\_\_\_ Direction \_\_\_\_\_ Type \_\_\_\_\_  
Well disinfected upon completion?  Yes  No

17. Pump: \_\_\_\_\_ Not installed  
Manufacturer's name Fairbanks Morros  
Model number \_\_\_\_\_ HP \_\_\_\_\_ Volts \_\_\_\_\_  
Length of drop pipe 100 ft. capacity 650 g.p.m.  
Type:  
 Submersible  Turbine  
 Jet  Reciprocating  
 Centrifugal  Other

18. Elevation:  
Topography:  
 Hill  
 Slope  
 Upland  
 Valley

19. Remarks:  
2967 (TOPO)

20. Water well contractor's certification:  
This well was drilled under my jurisdiction and this report is true to the best of my knowledge and belief.  
Northwest Drilling Co., Inc.  
Business name \_\_\_\_\_ License No. \_\_\_\_\_  
Address Goodland, Kansas (248)  
Signed Bent Hansen Date \_\_\_\_\_  
Authorized representative

T  
R  
M  
Sec  
18  
NW 1/4 NE  
1/4  
1/4  
1/4

Forward the white, blue and pink copies to the Department of Health and Environment

Form WWC-5