


1 LOCATION OF WATER WELL: County: SCOTT Fraction: SE 1/4 NW 1/4 SW 1/4 Section Number: 10 Township Number: T 18 S Range Number: R 35 E/W

Distance and direction from nearest town or city street address of well if located within city?

2 WATER WELL OWNER: V.L. Buckner
 RR#, St. Address, Box #: 11270 S Hereford Rd
 City, State, ZIP Code: Scott City, KS 67871
 Board of Agriculture, Division of Water Resource
 Application Number:

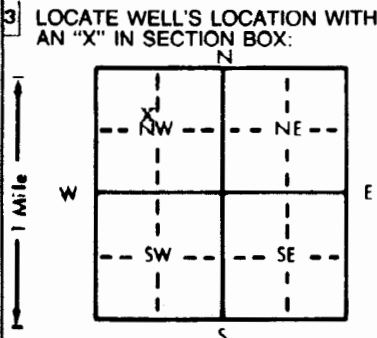

4 DEPTH OF COMPLETED WELL: 153 ft. ELEVATION: 136 ft.
 Depth(s) Groundwater Encountered 1. 136 ft. 2. 136 ft. 3. 136 ft.
 WELL'S STATIC WATER LEVEL: 136 ft. below land surface measured on mo/day/yr 1-22-99
 Pump test data: Well water was 138 ft. after 4 hours pumping 12 gpm
 Est. Yield 18 gpm: Well water was 138 ft. after 4 hours pumping 12 gpm
 Bore Hole Diameter: 9 5/8 in. to 0 ft. and 153 in. to 153 ft.
 WELL WATER TO BE USED AS:
 1 Domestic 3 Feedlot 6 Oil field water supply 8 Air conditioning 11 Injection well
 2 Irrigation 4 Industrial 7 Lawn and garden only 9 Dewatering 12 Other (Specify below)
stockwell
 Was a chemical/bacteriological sample submitted to Department? Yes No X; If yes, mo/day/yr sample was submitted
 Water Well Disinfected? Yes X No

5 TYPE OF BLANK CASING USED:
 1 Steel 3 RMP (SR) 5 Wrought iron 8 Concrete tile CASING JOINTS: Glued X Clamped
 2 PVC 4 ABS 6 Asbestos-Cement 9 Other (specify below) Welded
 7 Fiberglass Threaded
 Blank casing diameter: 5 in. to ft., Dia. in. to ft., Dia. in. to ft.
 Casing height above land surface: 2' 6" in., weight 200 PSI lbs./ft. Wall thickness or gauge No.
 TYPE OF SCREEN OR PERFORATION MATERIAL:
 1 Steel 3 Stainless steel 5 Fiberglass 7 PVC 10 Asbestos-cement
 2 Brass 4 Galvanized steel 6 Concrete tile 8 RMP (SR) 11 Other (specify)
 12 None used (open hole)
 SCREEN OR PERFORATION OPENINGS ARE:
 1 Continuous slot 3 Mill slot 5 Gauzed wrapped 8 Saw cut 11 None (open hole)
 2 Louvered shutter 4 Key punched 6 Wire wrapped 9 Drilled holes
 7 Torch cut 10 Other (specify)
 SCREEN-PERFORATED INTERVALS: From 153 ft. to 133 ft. From ft. to ft.
 From ft. to ft. From ft. to ft.
 GRAVEL PACK INTERVALS: From 153 ft. to 130 ft. From 120 ft. to 30 ft.
 From ft. to ft. From ft. to ft.

6 GROUT MATERIAL: 1 Neat cement 2 Cement grout 3 Bentonite 4 Other
 Grout Intervals: From 130 ft. to 120 ft., From 30 ft. to 0 ft., From ft. to ft.
 What is the nearest source of possible contamination:
 1 Septic tank 4 Lateral lines 7 Pit privy 10 Livestock pens 14 Abandoned water well
 2 Sewer lines 5 Cess pool 8 Sewage lagoon 11 Fuel storage 15 Oil well/Gas well
 3 Watertight sewer lines 6 Seepage pit 9 Feedyard 12 Fertilizer storage 16 Other (specify below)
 13 Insecticide storage
 Direction from well? W How many feet? 100

FROM	TO	LITHOLOGIC LOG	FROM	TO	PLUGGING INTERVALS
0	3	100 Soil	130	120	Bentonite
3	50	Clay	90	80	Bentonite
50	70	Sand and clay	30	0	Bentonite
70	82	Sand and gyp			
82	85	Gyp			
85	87	Med sand and clay			
87	148	Med sand			
148	153	Yellow to gray shale			

RECEIVED

FEB 17 1999

BUREAU OF WATER

7 CONTRACTOR'S OR LANDOWNER'S CERTIFICATION: This water well was (1) constructed, (2) reconstructed, or (3) plugged under my jurisdiction and was completed on (mo/day/year) 1-23-99 and this record is true to the best of my knowledge and belief. Kansas Water Well Contractor's License No. 640 This Water Well Record was completed on (mo/day/yr) 1-30-99 under the business name of Sager's Pump Service by (signature) Charles Sager

INSTRUCTIONS: Use typewriter or ball point pen. PLEASE PRESS FIRMLY and PRINT clearly. Please fill in blanks, underline or circle the correct answers. Send top three copies to Kansas Department of Health and Environment, Bureau of Water, Topeka, Kansas 66620-0001. Telephone: 913-296-5545. Send one to WATER WELL OWNER and retain one for your records.

Handwritten initials