

WATER WELL RECORD

Form WWC-5


Division of Water Resources App. No.

1 LOCATION OF WATER WELL: County: <u>Scott</u>	Fraction <u>1/4 NW 1/4 NE 1/4 NE 1/4</u>	Section Number <u>26</u>	Township No. <u>T 18 S</u>	Range Number <u>R 33</u> <input type="checkbox"/> E <input checked="" type="checkbox"/> W
--	---	-----------------------------	-------------------------------	--

Street/Rural Address of Well Location; if unknown, distance & direction from nearest town or intersection: If at owner's address, check here .
Rd 140 & Kansas Rd. 800' West on Rd. 140, 600' South

Global Positioning System (GPS) information:
 Latitude: (in decimal degrees)
 Longitude: (in decimal degrees)
 Elevation:
 Datum: WGS 84, NAD 83, NAD 27
 Collection Method:
 GPS unit (Make/Model:)
 Digital Map/Photo, Topographic Map, Land Survey
 Est. Accuracy: <3 m, 3-5 m, 5-15 m, >15 m

2 WATER WELL OWNER: Clif Morrison
 RR#, Street Address, Box #: 1891 W. Rd. 140
 City, State, ZIP Code : Scott City, Kansas 67871

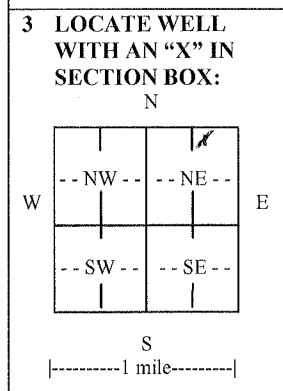

4 DEPTH OF COMPLETED WELL .173' ft.

Depth(s) Groundwater Encountered (1) .116' ft. (2)..... ft. (3)..... ft.

WELL'S STATIC WATER LEVEL .116' ft. below land surface measured on mo/day/yr.....

Pump test data: Well water was.....ft. after..... hours pumping..... gpm

EST. YIELD .28 gpm. Well water was .125 ft. after 4 hours pumping..... gpm

Bore Hole Diameter 10 in. to .173 ft., and in. to ft.

WELL WATER TO BE USED AS: Public water supply Geothermal Injection well
 Domestic Feedlot Oil field water supply Dewatering Other (Specify below)
 Irrigation Industrial Domestic-lawn & garden Monitoring well

Was a chemical/bacteriological sample submitted to Department? Yes No

If yes, mo/day/yr sample was submitted.....

Water well disinfected? Yes No

5 TYPE OF CASING USED: Steel PVC Other

CASING JOINTS: Glued Clamped Welded Threaded

Casing diameter .5 in. to .173 ft., Diameter in. to ft., Diameter in. to ft.

Casing height above land surface .18 in., Weight 200 lbs./ft., Wall thickness or gauge No. SDR 21

TYPE OF SCREEN OR PERFORATION MATERIAL:
 Steel Stainless Steel PVC Other (Specify)
 Brass Galvanized Steel None used (open hole)

SCREEN OR PERFORATION OPENINGS ARE:
 Continuous slot Mill slot Gauze wrapped Torch cut Drilled holes None (open hole)
 Louvered shutter Key punched Wire wrapped Saw cut Other (specify)

SCREEN-PERFORATED INTERVALS: From .143 ft. to .173 ft., From ft. to ft.
 From ft. to ft., From ft. to ft.

GRAVEL PACK INTERVALS: From .25 ft. to .125 ft., From ft. to ft.
 From .135 ft. to .173 ft., From ft. to ft.

6 GROUT MATERIAL: Neat cement Cement grout Bentonite Other

Grout Intervals: From .5 ft. to .25 ft., From .125 ft. to .135 ft., From ft. to ft.

What is the nearest source of possible contamination:
 Septic tank Lateral lines Pit privy Livestock pens Insecticide storage Other (specify below)
 Sewer lines Cesspool Sewage lagoon Fuel storage Abandoned water well
 Watertight sewer lines Seepage pit Feedyard Fertilizer storage Oil well/gas well

Direction from well West Distance from well .1000'

FROM	TO	LITHOLOGIC LOG	FROM	TO	LITHO. LOG (cont.) or PLUGGING INTERVALS
0	2	Top Soil	155	158	Brown clay, Few Sand Streaks
2	60	Brown Clay	158	170	Coarse Sand Small Gravel (Loose)
60	71	Medium to Coarse Sand, Small Gravel	170	182	Yellow Soapstone
71	78	Brown clay, Few Sand Streaks	182		Black Shale
78	117	Brown Clay, Gypsum			
117	125	Medium to Coarse Sand, Small Gravel			
125	136	Brown Clay			
136	148	Medium to Coarse Sand, Brown Clay			
		Streaks			
148	155	Medium to Coarse Sand, Small Gravel			

7 CONTRACTOR'S OR LANDOWNER'S CERTIFICATION: This water well was constructed, reconstructed, or plugged under my jurisdiction and was completed on (mo/day/year) 5/16/11..... and this record is true to the best of my knowledge and belief. Kansas Water Well Contractor's License No. 532..... This Water Well Record was completed on (mo/day/year) 6/4/11..... under the business name of Midwest Well & Pump Inc...... by (signature) [Signature].....

INSTRUCTIONS: Use typewriter or ball point pen. *PLEASE PRESS FIRMLY* and *PRINT* clearly. Please fill in blanks and check the correct answers. Send three copies (white, blue, pink) to Kansas Department of Health and Environment, Bureau of Water, Geology Section, 1000 SW Jackson St., Suite 420, Topeka, Kansas 66612-1367. Telephone 785-296-5522. Send one copy to WATER WELL OWNER and retain one for your records. Include fee of \$5.00 for each constructed well. Visit us at <http://www.kdheks.gov/waterwell/index.html>.