

WATER WELL RECORD

Form WWC-5


Division of Water Resources App. No.

1 LOCATION OF WATER WELL: County: Scott	Fraction $\frac{1}{4}$ NE $\frac{1}{4}$ NW $\frac{1}{4}$ NE $\frac{1}{4}$	Section Number 26	Township No. T 18 S	Range Number R 33 <input type="checkbox"/> E <input checked="" type="checkbox"/> W
--	--	-----------------------------	-------------------------------	--

Street/Rural Address of Well Location; if unknown, distance & direction from nearest town or intersection: If at owner's address, check here .
Kansas Rd. & Rd. 140 4 tenths mile west, 500' south

Global Positioning System (GPS) information:
 Latitude: (in decimal degrees)
 Longitude: (in decimal degrees)
 Elevation:
 Datum: WGS 84, NAD 83, NAD 27
 Collection Method:
 GPS unit (Make/Model:)
 Digital Map/Photo, Topographic Map, Land Survey
 Est. Accuracy: <3 m, 3-5 m, 5-15 m, >15 m

2 WATER WELL OWNER: **Matt Crist**
 RR#, Street Address, Box #: **14150 S. Falcon Rd.**
 City, State, ZIP Code : **Holcomb, KS 67851**

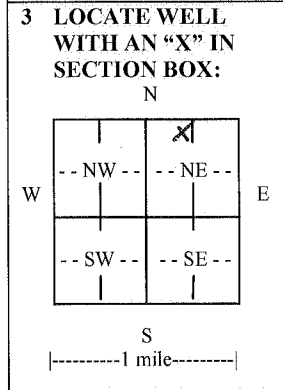

4 DEPTH OF COMPLETED WELL **.170** ft.

Depth(s) Groundwater Encountered (1)..... ft. (2)..... ft. (3)..... ft.
 WELL'S STATIC WATER LEVEL **.116** ft. below land surface measured on mo/day/yr.....
 Pump test data: Well water was **.35** ft. after **.3** hours pumping, **.35** gpm
 EST. YIELD **.50** gpm. Well water was..... ft. after..... hours pumping..... gpm
 Bore Hole Diameter **10** in. to **.170** ft., and..... in. to..... ft.
 WELL WATER TO BE USED AS: Public water supply Geothermal Injection well
 Domestic Feedlot Oil field water supply Dewatering Other (Specify below)
 Irrigation Industrial Domestic-lawn & garden Monitoring well
 Was a chemical/bacteriological sample submitted to Department? Yes No
 If yes, mo/day/yr sample was submitted.....
 Water well disinfected? Yes No

5 TYPE OF CASING USED: Steel PVC Other

CASING JOINTS: Glued Clamped Welded Threaded
 Casing diameter **.5** in. to **.170** ft., Diameter in. to ft., Diameter in. to ft.
 Casing height above land surface **.18** in., Weight **200** lbs./ft., Wall thickness or gauge No. **SDR21**

TYPE OF SCREEN OR PERFORATION MATERIAL:
 Steel Stainless Steel PVC Other (Specify)
 Brass Galvanized Steel None used (open hole)

SCREEN OR PERFORATION OPENINGS ARE:
 Continuous slot Mill slot Gauze wrapped Torch cut Drilled holes None (open hole)
 Louvered shutter Key punched Wire wrapped Saw cut Other (specify)

SCREEN-PERFORATED INTERVALS: From **.140** ft. to **.170** ft., From ft. to ft.
 From ft. to ft., From ft. to ft.
 GRAVEL PACK INTERVALS: From **.25** ft. to **.170** ft., From ft. to ft.
 From ft. to ft., From ft. to ft.

6 GROUT MATERIAL: Neat cement Cement grout Bentonite Other

Grout Intervals: From **.5** ft. to **.25** ft., From ft. to ft., From ft. to ft.

What is the nearest source of possible contamination:
 Septic tank Lateral lines Pit privy Livestock pens Insecticide storage Other (specify below)
 Sewer lines Cesspool Sewage lagoon Fuel storage Abandoned water well
 Watertight sewer lines Seepage pit Feedyard Fertilizer storage Oil well/gas well

Direction from well **.300'** Distance from well **North East**

FROM	TO	LITHOLOGIC LOG	FROM	TO	LITHO. LOG (cont.) or PLUGGING INTERVALS
0	2	Top Soil	140	145	Cemented Sand
2	53	Brown Sandy Clay	145	153	Light Brown Clay, Few Medium Sand
53	62	Medium to Coarse Sand, Brown Clay			Streaks
		Streaks	153	163	Medium to Fine Sand
62	94	Brown Clay, Few Gypsum and Cemented	163	166	Medium to Coarse Sand
		Sand Streaks	166	170	Brown Clay
94	110	Medium to Coarse Sand, Cementes Str			
110	120	Brown Clay, Few Small Sand Streaks			
120	125	Medium to Coarse Sand Small Gravel			
125	140	Light Brown Clay, Cemented Sand Str			

7 CONTRACTOR'S OR LANDOWNER'S CERTIFICATION: This water well was constructed, reconstructed, or plugged under my jurisdiction and was completed on (mo/day/year) **.11-.11-.13** and this record is true to the best of my knowledge and belief. Kansas Water Well Contractor's License No. **.532** This Water Well Record was completed on (mo/day/year) **.11-.18-.13** under the business name of **.Midwest Well & Pump Inc.** by (signature) *[Signature]*

INSTRUCTIONS: Use typewriter or ball point pen. PLEASE PRESS FIRMLY and PRINT clearly. Please fill in blanks and check the correct answers. Send three copies (white, blue, pink) to Kansas Department of Health and Environment, Bureau of Water, Geology Section, 1000 SW Jackson St., Suite 420, Topeka, Kansas 66612-1367. Telephone 785-296-5522. Send one copy to WATER WELL OWNER and retain one for your records. Include fee of \$5.00 for each constructed well. Visit us at <http://www.kdheks.gov/waterwell/index.html>.