
| | | | | WWC-5 | | ivision of Wa | | | | MW-5 | | |
|---|---|--------------------------------|-----------------------|--|----------------------|---|--|---------------------------------------|---------------------------------------|-------------------|--|--|
| | | | | e in Well Use | | sources App. | | # 1: N 1 | Well ID | NT1 | | |
| | | WATER WELL: | | Fraction | | ection Numl | oer | Township Numb | | nge Number | | |
| County. | | | | | | | | | | | | |
| | | Last Name: Dept of Health & | Envir | First: | | tion from nearest town or intersection): If at owner's address, check here: | | | | | | |
| Address | | V Jackson St. | | | · | | | | | | | |
| Address: | | | | | SE corner | E. 3rd & C | ourt s | Sts., Scott City | | | | |
| City: | Topeka | Stat | e: KS | ZIP: 66612 | | | | | | | | |
| 3 LOCAT | | 4 DEPTH OF | F COM | IPLETED WELL: . | 227 | ft. 5 Lati | tude: | 38.48443 | 36 | (decimal degrees) | | |
| WITH | "X" IN ON BOX: | | | Encountered: 1) | | Lon | gitud | e: -100.908 | 156 | (decimal degrees) | | |
| | N | | | 3) ft., or 4) [| | Hori | zontal | Datum: WGS 84 | □ NAD | 83 NAD 27 | | |
| l — | | | | TER LEVEL: | | | | Latitude/Longitude: | | | | |
| | below land surface, measured on (mo-day- | | | | | | | unit make/model: | | | | |
| above land surface, measured on (mo-day-yr) Pump test data: Well water was | | | | | | (WAAS enabled? ☐ Yes ☐ No) ☐ Land Survey ☐ Topographic Map | | | | | | |
| W E after hours pumping | | | | | | | Online | Mapper: Google | Earth | | | |
| | Well water was ft. | | | | | | | · · · · · · · · · · · · · · · · · · · | | | | |
| SW | | pumping | gpm | 6 Flor | ation | . α | Crown d | I aval 🗆 TOC | | | | |
| | Estimated Yield:gpm Bore Hole Diameter:9in. to231 | | | | | | 6 Elevation:ft. ☐ Ground Level ☐ TOC Source: ☐ Land Survey ☐ GPS ☐ Topographic Map | | | | | |
| | | | | | | Other | | | | | | |
| 7 WELL WATER TO BE USED AS: | | | | | | | | | | | | |
| 1. Domestic | | | blic Wa | ter Supply: well ID | | 10. □ 0 | oil Fie | ld Water Supply: le | ase | | | |
| ☐ House | ☐ Household 6. ☐ Dewatering: how many wells? | | | | | | | | | | | |
| _ | & Garden | 7. 🔲 Aq | uifer Re | echarge: well ID | | | | ☐ Uncased ☐ C | | | | |
| Livest | | | | | | | | al: how many bores | | | | |
| | 2. Irrigation 9. Environmental Remediation: well ID | | | | | | a) Closed Loop Horizontal Vertical | | | | | |
| . — | 3. | | | | | | b) Open Loop Surface Discharge Inj. of Water 13. Other (specify): | | | | | |
| | | | | | | | | | | | | |
| Was a chemical/bacteriological sample submitted to KDHE? ☐ Yes ■ No If yes, date sample was submitted: | | | | | | | | | | | | |
| 8 TYPE OF CASING USED: ☐ Steel ■ PVC ☐ Other | | | | | | | | | | | | |
| Casing diameter in. to | | | | | | | | | | | | |
| Casing height above land surface in. Weight | | | | | | | | | | | | |
| TYPE OF SCREEN OR PERFORATION MATERIAL: | | | | | | | | | | | | |
| ☐ Steel ☐ Stainless Steel ☐ Fiberglass ■ PVC ☐ Other (Specify) | | | | | | | | | | | | |
| ☐ Brass ☐ Galvanized Steel ☐ Concrete tile ☐ None used (open hole) | | | | | | | | | | | | |
| SCREEN OR PERFORATION OPENINGS ARE: | | | | | | | | | | | | |
| ☐ Continuous Slot ☐ Mill Slot ☐ Gauze Wrapped ☐ Torch Cut ☐ Drilled Holes ☐ Other (Specify) | | | | | | | | | | | | |
| SCREEN-PERFORATED INTERVALS: From187 ft. to .227 ft., From ft., From ft., From ft. | | | | | | | | | | | | |
| GRAVEL PACK INTERVALS: From 178 ft. to 231 ft., From ft. to ft., From ft. to ft. | | | | | | | | | | | | |
| 9 GROUT MATERIAL: ■ Neat cement □ Cement grout ■ Bentonite □ Other | | | | | | | | | | | | |
| 9 GROUT MATERIAL: ■ Neat cement | | | | | | | | | | | | |
| | | ole contamination: | | | | | | _ | | | | |
| ☐ Septic | | ☐ Later | | | | Livestock P | | ☐ Insectici | | TY 11 | | |
| ☐ Sewer | Lines ight Sewer L | ☐ Cess ines ☐ Seepa | | ☐ Sewage Lag ☐ Feedyard | | Fuel Storage Fertilizer St | | ☐ Abandor ☐ Oil Well | | Well | | |
| Other (Specify) | | | | | | | | | | | | |
| Direction from well? Distance from well? ft. | | | | | | | | | | | | |
| 10 FROM | TO | | | IC LOG | FROM | TO | | IO. LOG (cont.) or l | PLUGGING | G INTERVALS | | |
| 0 | 68 | Clay | | | 167 | 177 | | d, Brown | | | | |
| 68 | 74 | Sand, f-m, Brow | n | | 177 192 | 192 | | , Brown | | | | |
| 74 | 88 | Clay, Brown | | | | 200 | | d, f-m, Brown | | | | |
| 88 | 102 | Sand, f-m, Brown | | | | 206 | | , Brown | | | | |
| 102 | 125 | Clay, Brown | | | | 221 | | nd, f-m, Brown | | | | |
| 125 | 143 | | aliche, White w/Brown | | | 223 Sand/Clay layer, cemented | | | | | | |
| 143 | 147 | Clay, Brown | | | | | Notes: 223 to 231 Shale, highly wthrd, Yellow | | | | | |
| 147 155 Sand, f-m, Brown | | | | | | | | | | | | |
| 155 167 Clay, Brown 11 CONTRACTOR'S OR LANDOWNER'S CERTIFICATION: This water well was ■ constructed, □ reconstructed, or □ plugged | | | | | | | | | | | | |
| under my jurisdiction and was completed on (mo-day-year) .10/4/2018 and this record is true to the best of my knowledge and belief. | | | | | | | | | | | | |
| Kansas Wa | นางนายนอก 8 ter Well Co | ntractor's License | No 52 | o-day-year) . 1.01.402.1 27 This Wa | ∨ and ter Well Re | cord was co | ısurut manlet | ed on omo-day-ve | ar) .10/3.1 | 2018 | | |
| under the b | usiness nan | ne of .GeoCore.In |)Ç | | S | gnature | | L. 160-C | · · · · · · · · · · · · · · · · · · · | | | |
| Mail | l white copy a | long with a fee of \$5.00 | for each | constructed well to: Kan | sas Departmen | of Health and | Enviro | onment, Bureau of Wat | ter, GWTS S | ection, | | |
| | | | | 6612-1367. Mail one to V | | | one for | your records. Telepho | | | | |
| Visit us at http | ://www.kdhel | s.gov/waterwell/index. | html | | KSA 82a-12 | 412 | | | Kevised | 7/10/2015 | | |

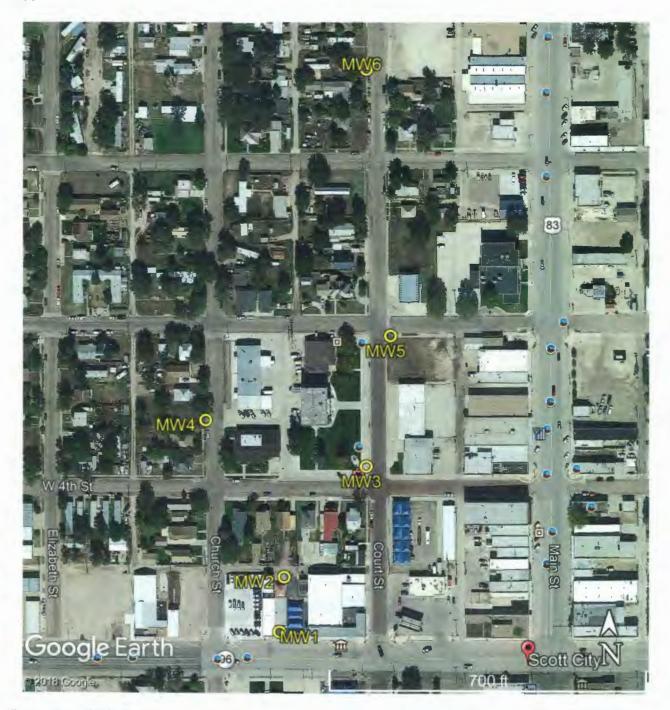

Former Donna's Cleaners 216 W. 5th Street, Scott City

GPS Coordinates:

MW-1: 38.482637, -100.909008 MW-2: 38.482973, -100.908972 MW-3: 38.483645, -100.908342 MW-4: 38.483923, -100.909577 MW-5: 38.484436, -100.908156 MW-6: 38.486048, -100.908340 RECEIVED

JAN 1 1 2019

BUREAU OF WATER