


**WATER WELL RECORD Form WWC-5 "KSA 82a-1212"**

**1 LOCATION OF WATER WELL:** Fraction SE 1/4 SE 1/4 NW 1/4 Section Number 2 Township Number T 18 S Range Number R 33 E  
 County: Scott

Distance and direction from nearest town or city street address of well if located within city?  
2 1/2 miles North 1 1/2 miles West of Scott City, Kansas

**2 WATER WELL OWNER:** Bar 5 Farms  
 RR#, St. Address, Box #: Rfd # 3 Board of Agriculture, Division of Water Resources  
 City, State, ZIP Code: Scott City, Kansas 67871 Application Number:

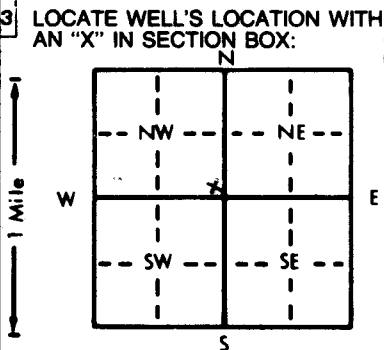

**4 DEPTH OF COMPLETED WELL:** 205 ft. ELEVATION:  
 Depth(s) Groundwater Encountered 1. 124 ft. 2. ft. 3. ft.  
 WELL'S STATIC WATER LEVEL 124 ft. below land surface measured on mo/day/yr 2/15/88  
 NA Pump test data: Well water was ft. after hours pumping gpm  
 Est. Yield gpm: Well water was ft. after hours pumping gpm  
 Bore Hole Diameter 9 in. to 205 ft., and in. to ft.  
 WELL WATER TO BE USED AS: 5 Public water supply 8 Air conditioning 11 Injection well  
1 Domestic 3 Feedlot 6 Oil field water supply 9 Dewatering 12 Other (Specify below)  
 2 Irrigation 4 Industrial 7 Lawn and garden only 10 Observation well  
 Was a chemical/bacteriological sample submitted to Department? Yes No X; If yes, mo/day/yr sample was submitted  
 Water Well Disinfected? Yes X No

**5 TYPE OF BLANK CASING USED:** 5 Wrought iron 8 Concrete tile CASING JOINTS: Glued Clamped  
 1 Steel 3 RMP (SR) 6 Asbestos-Cement 9 Other (specify below) Welded  
2 PVC 4 ABS 7 Fiberglass Threaded  
 Blank casing diameter 5 in. to 185 ft., Dia in. to ft., Dia in. to ft.  
 Casing height above land surface 12 in., weight lbs./ft. Wall thickness or gauge No.  
 TYPE OF SCREEN OR PERFORATION MATERIAL: 7 PVC 10 Asbestos-cement  
 1 Steel 3 Stainless steel 5 Fiberglass 8 RMP (SR) 11 Other (specify)  
 2 Brass 4 Galvanized steel 6 Concrete tile 9 ABS 12 None used (open hole)  
 SCREEN OR PERFORATION OPENINGS ARE: 5 Gauzed wrapped 8 Saw cut 11 None (open hole)  
 1 Continuous slot 3 Mill slot 6 Wire wrapped 9 Drilled holes  
 2 Louvered shutter 4 Key punched 7 Torch cut 10 Other (specify)  
 SCREEN-PERFORATED INTERVALS: From 185 ft. to 205 ft., From ft. to ft.  
 From ft. to ft., From ft. to ft.  
 GRAVEL PACK INTERVALS: From 125 ft. to 205 ft., From ft. to ft.  
 From ft. to ft., From ft. to ft.

**6 GROUT MATERIAL:** 1 Neat cement 2 Cement grout 3 Bentonite 4 Other Drill cuttings  
 Grout intervals: From 25 ft. to 125 ft., From 4 ft. to 25 ft., From ft. to ft.  
 What is the nearest source of possible contamination:  
1 Septic tank 4 Lateral lines 7 Pit privy 10 Livestock pens 14 Abandoned water well  
 2 Sewer lines 5 Cess pool 8 Sewage lagoon 11 Fuel storage 15 Oil well/Gas well  
 3 Watertight sewer lines 6 Seepage pit 9 Feedyard 12 Fertilizer storage 16 Other (specify below)  
 13 Insecticide storage  
 Direction from well? Southwest How many feet? 150

FROM	TO	LITHOLOGIC LOG	FROM	TO	LITHOLOGIC LOG
0	27	Clay	27	31	Sand
31	55	Clay	55	73	Caliche
73	88	Fine sand clay streaks	88	98	Sand
98	101	Sand cemented	101	120	Sand
120	150	Fine sand clay streaks	150	152	Clay
152	160	Fine sand	160	164	Sand
164	180	Fine sand	180	190	Fine sand clay streaks
190	197	Fine sand	197	202	Sand medium
202	205	Clay			

**7 CONTRACTOR'S OR LANDOWNER'S CERTIFICATION:** This water well was (1) constructed, (2) reconstructed, or (3) plugged under my jurisdiction and was completed on (mo/day/year) 2/16/88 and this record is true to the best of my knowledge and belief. Kansas Water Well Contractor's License No. 232. This Water Well Record was completed on (mo/day/yr) 2/19/88 under the business name of Weishaar Drilling & Supply Inc. by (signature) [Signature]

INSTRUCTIONS: Use typewriter or ball point pen. PLEASE PRESS FIRMLY and PRINT clearly. Please fill in blanks, underline or circle the correct answers. Send top three copies to Kansas Department of Health and Environment, Bureau of Water Protection, Topeka, Kansas 66620-7320, Telephone: 913-862-9360. Send one to WATER WELL OWNER and retain one for your records.