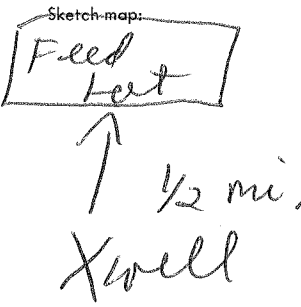


USE TYPEWRITER OR BALL POINT PEN-PRESS FIRMLY, PRINT CLEARLY.

WATER WELL RECORD
KSA 82a-1201-1215

Kansas Department of Health and Environment-Division of Environment
(Water well Contractors)
Topeka, Kansas 66620

1. Location of well:		County Scott	Fraction NE 1/4 NE 1/4 SW 1/4	Section number 12	Township number T 18 S R 33	Range number 33	E/W	
2. Distance and direction from nearest town or city: Street address of well location if in city:			1N, 1/2W, 1/2N of Scott City, KS		3. Owner of well: R.R. or street: City, state, zip code:			Brookovers RFD #1 Scott City, KS 67871
4. Locate with "X" in section below:				Sketch-map: 		6. Bore hole dia. <u>26</u> in. Completion date _____ Well depth <u>202</u> ft. <u>3-29-76</u>		
5. Type and color of material				From	To	7. <input type="checkbox"/> Cable tool <input type="checkbox"/> Rotary <input type="checkbox"/> Driven <input type="checkbox"/> Dug <input type="checkbox"/> Hollow rod <input type="checkbox"/> Jetted <input type="checkbox"/> Bored <input checked="" type="checkbox"/> Reverse rotary		
Clay				0	12	8. Use: <input type="checkbox"/> Domestic <input type="checkbox"/> Public supply <input type="checkbox"/> Industry <input checked="" type="checkbox"/> Irrigation <input type="checkbox"/> Air conditioning <input type="checkbox"/> Stock <input type="checkbox"/> Lawn <input type="checkbox"/> Oil field water <input type="checkbox"/> Other		
Sd coarse				12	22	9. Casing: Material <u>Steel</u> Height: <u>Above</u> or below Threaded <input type="checkbox"/> Welded <input checked="" type="checkbox"/> Surface <u>10</u> in. RMP <input type="checkbox"/> PVC <input type="checkbox"/> Weight <u>31.67</u> lbs./ft. Dia. <u>16</u> in. to <u>202</u> ft. depth Wall Thickness: inches or Dia. _____ in. to _____ ft. depth gage No. <u>188</u>		
Fine sd clay				22	37	10. Screen: Manufacturer's name <u>Johnson</u> <u>Colv. & Prime & Free Flow</u> Type <u>Steel</u> Dia. <u>16</u> in. <u>100 & 125</u> Length <u>70</u> ft. Set between <u>132</u> ft. and <u>202</u> ft. _____ ft. and _____ ft. Gravel pack? <u>yes</u> Size range of material <u>3/4-1/2</u> ft.		
Sd coarse				37	63	11. Static water level: _____ mo./day/yr. <u>85</u> ft. below land surface Date <u>1-20-76</u>		
Clay				63	75	12. Pumping level below land surfaces: <u>170</u> ft. after <u>4</u> hrs. pumping <u>1350</u> g.p.m. <u>180</u> ft. after <u>4</u> hrs. pumping <u>1430</u> g.p.m. Estimated maximum yield <u>1430</u> g.p.m.		
Gyp				75	80	13. Water sample submitted: _____ mo./day/yr. Yes <input type="checkbox"/> No <input checked="" type="checkbox"/> Date _____		
Clay				80	87	14. Well head completion: <input type="checkbox"/> Pitless adapter _____ inches above grade		
Gyp				87	96	15. Well grouted? _____ With: <input checked="" type="checkbox"/> Neat cement <input type="checkbox"/> Bentonite <input type="checkbox"/> Concrete Depth: From <u>0</u> ft. to <u>10</u> ft.		
Clay				96	100	16. Nearest source of possible contamination: ft. <u>2640</u> Direction <u>N</u> Type <u>Feed Lot</u> Well disinfected upon completion? <input checked="" type="checkbox"/> Yes <input type="checkbox"/> No		
Fine sd clay				100	110	17. Pump: _____ Not installed Manufacturer's name <u>Simmons</u> Model number <u>EE</u> HP <u>75</u> Volts <u>460</u> Length of drop pipe <u>180</u> ft. capacity <u>1430</u> g.p.m. Type: <input type="checkbox"/> Submersible <input checked="" type="checkbox"/> Turbine <input type="checkbox"/> Jet <input type="checkbox"/> Reciprocating <input type="checkbox"/> Centrifugal <input type="checkbox"/> Other		
Sd rock				110	119	18. Elevation:		
Sd coarse				119	139	19. Remarks: Fine sd clay Yellow Shale		
Sd rock H				139	157	20. Water well contractor's certification: This well was drilled under my jurisdiction and this report is true to the best of my knowledge and belief. <u>Weishaar Drilling</u> <u>232</u> Business name License No. Address <u>Scott City, KS 67871</u> Signed <u>[Signature]</u> Date <u>7-20-76</u> Authorized representative		
Clay				157	161	Topography: <input type="checkbox"/> Hill <input checked="" type="checkbox"/> Slope <input type="checkbox"/> Upland <input type="checkbox"/> Valley		
Fine sd				161	173	1/4 1/4 1/4		
Sd coarse				173	191	1/4 1/4 1/4		
18. Elevation:				191	200	Sec 2		
19. Remarks:				200	215			
Topography:				215				

Forward the white, blue and pink copies to the Department of Health and Environment

Form WWC-5