


1 LOCATION OF WATER WELL: County: Scott Fraction: $\frac{1}{4}$ NW $\frac{1}{4}$ NE $\frac{1}{4}$ Section Number: 21 Township Number: T 18 S Range Number: R 33 E(W)

Distance and direction from nearest town or city street address of well if located within city?
3 1/2 miles west of Scott City on 96 hwy. Lot 4, Whitham Track

2 WATER WELL OWNER: Bill Winters
 RR#, St. Address, Box #: Route #3 Board of Agriculture, Division of Water Resources
 City, State, ZIP Code: Scott City, Ks. 67871 Application Number:

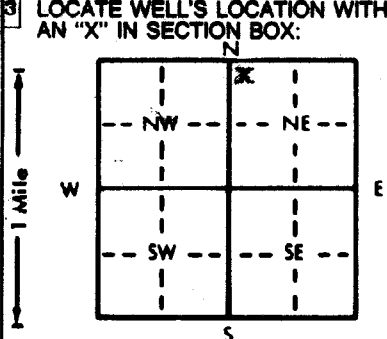

4 DEPTH OF COMPLETED WELL: 125 ft. ELEVATION: ft.
 Depth(s) Groundwater Encountered 1. ft. 2. ft. 3. ft.
 WELL'S STATIC WATER LEVEL: 100 ft. below land surface measured on mo/day/yr 7-14-86
 Pump test data: Well water was ft. after hours pumping gpm
 Est. Yield 17 gpm: Well water was ft. after hours pumping gpm
 Bore Hole Diameter: 12 in. to 125 in. to in. to ft.
 WELL WATER TO BE USED AS:
 Domestic 3 Feedlot 6 Oil field water supply 9 Dewatering 12 Other (Specify below)
 2 Irrigation 4 Industrial 7 Lawn and garden only 10 Observation well
 Was a chemical/bacteriological sample submitted to Department? Yes.....No.....; If yes, mo/day/yr sample was submitted
 Water Well Disinfected? Yes No

5 TYPE OF BLANK CASING USED:
 1 Steel 3 RMP (SR) 5 Wrought iron 8 Concrete tile CASING JOINTS: Glued Clamped
 PVC 4 ABS 6 Asbestos-Cement 9 Other (specify below) Welded
 7 Fiberglass Threaded.....
 Blank casing diameter: 5 in. to 100 ft., Dia in. to ft., Dia in. to ft.
 Casing height above land surface: 12 in., weight lbs./ft. Wall thickness or gauge No. 200 psi
 TYPE OF SCREEN OR PERFORATION MATERIAL: PVC 10 Asbestos-cement
 1 Steel 3 Stainless steel 5 Fiberglass 8 RMP (SR) 11 Other (specify)
 2 Brass 4 Galvanized steel 6 Concrete tile 9 ABS 12 None used (open hole)
 SCREEN OR PERFORATION OPENINGS ARE:
 1 Continuous slot 3 Mill slot 5 Gauzed wrapped Saw cut 11 None (open hole)
 2 Louvered shutter 4 Key punched 6 Wire wrapped 9 Drilled holes
 7 Torch cut 10 Other (specify)
 SCREEN-PERFORATED INTERVALS: From 100 ft. to 125 ft., From ft. to ft.
 From ft. to ft., From ft. to ft.
 GRAVEL PACK INTERVALS: From 16 ft. to 95 ft., From ft. to ft.
 From 105 ft. to 125 ft., From ft. to ft.

6 GROUT MATERIAL: Neat cement 2 Cement grout Bentonite 4 Other
 Grout Intervals: From 6 ft. to 16 ft., From 95 ft. to 105 ft., From ft. to ft.
 What is the nearest source of possible contamination:
 Septic tank 4 Lateral lines 7 Pit privy 10 Livestock pens 14 Abandoned water well
 2 Sewer lines 5 Cess pool 8 Sewage lagoon 11 Fuel storage 15 Oil well/Gas well
 3 Watertight sewer lines 6 Seepage pit 9 Feedyard 12 Fertilizer storage 16 Other (specify below)
 13 Insecticide storage
 Direction from well? How many feet? 100

FROM	TO	LITHOLOGIC LOG	FROM	TO	LITHOLOGIC LOG
0	2	top soil			
2	20	brown clay			
20	40	brown clay & gypsum			
40	100	fine to coarse sand, clay streaks			
100	112	fine sand			
112	117	brown clay			
117	122	fine sand			
122	132	yellow clay			
132	-	black shale			

7 CONTRACTOR'S OR LANDOWNER'S CERTIFICATION: This water well was constructed, (2) reconstructed, or (3) plugged under my jurisdiction and was completed on (mo/day/year) 7-14-86 and this record is true to the best of my knowledge and belief. Kansas Water Well Contractor's License No. 449 This Water Well Record was completed on (mo/day/yr) 7-18-86 under the business name of Midwest Well & Pump by (signature) Arthur Kuhlman

INSTRUCTIONS: Use typewriter or ball point pen. PLEASE PRESS FIRMLY and PRINT clearly. Please fill in blanks, underline or circle the correct answers. Send top three copies to Kansas Department of Health and Environment, Office of Oil Field and Environmental Geology, Regulation and Permitting Section, Topeka, Kansas 66620-7500, Telephone: 913-862-9360. Send one to WATER WELL OWNER and retain one for your records.