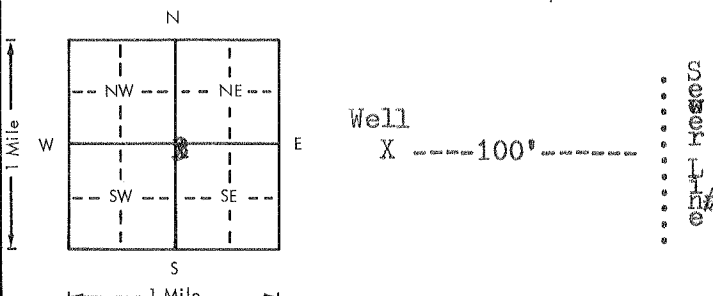


USE TYPEWRITER OR BALL POINT PEN-PRESS FIRMLY, PRINT CLEARLY.

WATER WELL RECORD
KSA 82a-1201-1215

Kansas Department of Health and Environment-Division of Environment
(Water well Contractors)
Topeka, Kansas 66620

1. Location of well:	County Scott	Fraction N/W1/4 N/W1/4 S/E 1/4	Section number 24	Township number T 18 S R 33	Range number ##N
2. Distance and direction from nearest town or city: Street address of well location if in city: 1202 Jackson Street			3. Owner of well: Floyd Stanton R.R. or street: 1202 Jackson St. City, state, zip code: Scott City, Kansas 67871		
4. Locate with "X" in section below: Sketch map: 			6. Bore hole dia. <u>9</u> in. Completion date _____ Well depth <u>204</u> ft. <u>9-10-1977</u>		
5. Type and color of material			7. <input type="checkbox"/> Cable tool <input checked="" type="checkbox"/> Rotary <input type="checkbox"/> Driven <input type="checkbox"/> Dug <input type="checkbox"/> Hollow rod <input type="checkbox"/> Jetted <input type="checkbox"/> Bored <input type="checkbox"/> Reverse rotary		
			8. Use: <input checked="" type="checkbox"/> Domestic <input type="checkbox"/> Public supply <input type="checkbox"/> Industry <input type="checkbox"/> Irrigation <input type="checkbox"/> Air conditioning <input type="checkbox"/> Stock <input checked="" type="checkbox"/> Lawn <input type="checkbox"/> Oil field water <input type="checkbox"/> Other		
			9. Casing: Material <u>Plast</u> Height: Above or below Threaded _____ Welded <u>Glue</u> Surface <u>12</u> in. RMP <input checked="" type="checkbox"/> PVC _____ Weight <u>1.8</u> lbs./ft. Dia. <u>5</u> in. to <u>184</u> ft. depth Wall Thickness: inches or Dia. _____ in. to _____ ft. depth gage No. <u>250</u>		
			10. Screen: Manufacturer's name <u>Jess & Lowell</u> Type <u>RMP</u> Dia. <u>5"</u> Slot/gauge <u>1/16"</u> Length <u>20"</u> Set between <u>184</u> ft. and <u>204</u> ft. Gravel pack? <u>yes</u> Size range of material <u>1/4 X 1/8</u>		
			11. Static water level: _____ mo./day/yr. <u>97</u> ft. below land surface Date <u>8-29-77</u>		
			12. Pumping level below land surfaces: <u>120</u> ft. after <u>4</u> hrs. pumping <u>60</u> g.p.m. _____ ft. after _____ hrs. pumping _____ g.p.m. Estimated maximum yield _____ g.p.m. <u>60</u>		
			13. Water sample submitted: _____ mo./day/yr. Yes <input type="checkbox"/> No <input checked="" type="checkbox"/> Date _____		
			14. Well head completion: <input checked="" type="checkbox"/> Pitless adapter <u>12</u> Inches above grade		
			15. Well grouted? <u>yes</u> With: <input checked="" type="checkbox"/> Neat cement <input type="checkbox"/> Bentonite <input type="checkbox"/> Concrete Depth: From <u>0</u> ft. to <u>20</u> ft.		
			16. Nearest source of possible contamination: ft. <u>100</u> Direction <u>East</u> Type <u>Sewer Line</u> Well disinfected upon completion? <input checked="" type="checkbox"/> Yes <input type="checkbox"/> No		
			17. Pump: Not installed Manufacturer's name <u>Could's</u> Model number <u>UTM50412</u> HP <u>5</u> Volts <u>230</u> Length of drop pipe <u>189</u> ft. capacity <u>60</u> g.p.m. Type: <input checked="" type="checkbox"/> Submersible <input type="checkbox"/> Turbine <input type="checkbox"/> Jet <input type="checkbox"/> Reciprocating <input type="checkbox"/> Centrifugal <input type="checkbox"/> Other		
18. Elevation:			20. Water well contractor's certification: This well was drilled under my jurisdiction and this report is true to the best of my knowledge and belief. <u>Weishaar Drilling</u> <u>232</u> Business name License No. Address <u>Scott City, Kansas</u> Signed <u>[Signature]</u> Date <u>10/6/77</u> Authorized representative		
19. Remarks: Topography: <input type="checkbox"/> Hill <input type="checkbox"/> Slope <input checked="" type="checkbox"/> Upland <input type="checkbox"/> Valley					

T 18
 R 33
 Sec 24
 1/4 NW 1/4 SE

Forward the white, blue and pink copies to the Department of Health and Environment

Form WWC-5