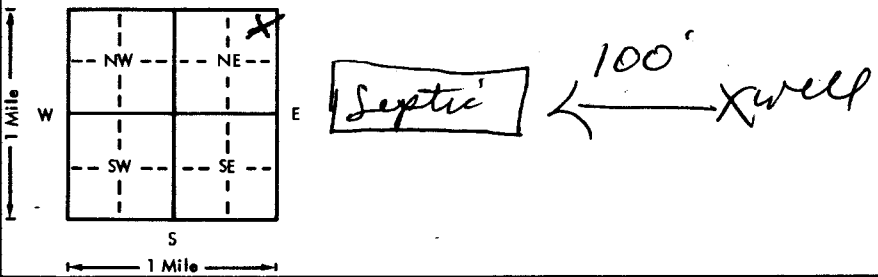


USE TYPEWRITER OR BALL POINT PEN-PRESS FIRMLY, PRINT CLEARLY.

WATER WELL RECORD
KSA 82a-1201-1215

Kansas Department of Health and Environment-Division of Environment
(Water well Contractors)
Topeka, Kansas 66620

1. Location of well:		County Scott	Fraction NE 1/4 NE 1/4 NE 1/4	Section number 34	Township number T 18 S R 33	Range number 33
2. Distance and direction from nearest town or city: 2S, 2W of Street address of well location if in city: Scott City, Kansas			3. Owner of well: Roy Daniels R.R. or street: Box 514 City, state, zip code: Scott City, KS 67871			
4. Locate with "X" in section below: N W E S 1 Mile			Sketch map: 		6. Bore hole dia. <u>9</u> in. Completion date _____ Well depth <u>140</u> ft. <u>11-19-76</u>	
5. Type and color of material			From	To	7. <input checked="" type="checkbox"/> Cable tool <input checked="" type="checkbox"/> Rotary <input type="checkbox"/> Driven <input type="checkbox"/> Dug <input type="checkbox"/> Hollow rod <input type="checkbox"/> Jetted <input type="checkbox"/> Bored <input type="checkbox"/> Reverse rotary	
Clay			0	63	8. Use: <input checked="" type="checkbox"/> Domestic <input type="checkbox"/> Public supply <input type="checkbox"/> Industry <input type="checkbox"/> Irrigation <input type="checkbox"/> Air conditioning <input type="checkbox"/> Stock <input type="checkbox"/> Lawn <input type="checkbox"/> Oil field water <input type="checkbox"/> Other	
Gyp			63	84	9. Casing: Material <u>Plas.</u> Height <u>Above</u> or below Threaded _____ Welded <u>Glue</u> Surface <u>12</u> in. RMP <input checked="" type="checkbox"/> PVC _____ Weight <u>1.8</u> lbs./ft. Dia. <u>5</u> in. to <u>120</u> ft. depth Wall Thickness: inches or Dia. _____ in. to _____ ft. depth gage No. <u>250</u>	
Fine sd clay			84	137	10. Screen: Manufacturer's name <u>Jess & Lowell</u> Type <u>RMP</u> Dia. <u>5in.</u> <u>Clot/gauze</u> <u>1/16</u> Length <u>20 ft.</u> Set between <u>120</u> ft. and <u>140</u> ft. _____ ft. and _____ ft. Gravel pack? <input checked="" type="checkbox"/> <u>yes</u> Size range of material <u>1/4-1/8</u>	
Clay yellow			137	140	11. Static water level: _____ mo./day/yr. <u>89</u> ft. below land surface Date <u>11-18-76</u>	
					12. Pumping level below land surfaces: <u>NA</u> _____ ft. after _____ hrs. pumping _____ g.p.m. _____ ft. after _____ hrs. pumping _____ g.p.m. Estimated maximum yield _____ g.p.m.	
					13. Water sample submitted: _____ mo./day/yr. Yes <input checked="" type="checkbox"/> No <input type="checkbox"/> Date _____	
					14. Well head completion: <input checked="" type="checkbox"/> Pitless adapter <u>12</u> inches above grade	
					15. Well grouted? <u>yes</u> With: <input checked="" type="checkbox"/> Neat cement _____ Bentonite _____ Concrete _____ Depth: From <u>0</u> ft. to <u>15</u> ft.	
					16. Nearest source of possible contamination: ft. <u>100</u> Direction <u>W</u> Type <u>Septic</u> Well disinfected upon completion? <input checked="" type="checkbox"/> Yes <input type="checkbox"/> No	
					17. Pump: <input checked="" type="checkbox"/> Not installed Manufacturer's name _____ Model number _____ HP _____ Volts _____ Length of drop pipe _____ ft. capacity _____ g.p.m. Type: <input type="checkbox"/> Submersible <input type="checkbox"/> Turbine <input type="checkbox"/> Jet <input type="checkbox"/> Reciprocating <input type="checkbox"/> Centrifugal <input type="checkbox"/> Other	
			(Use a second sheet if needed)			
18. Elevation:		19. Remarks:		20. Water well contractor's certification: This well was drilled under my jurisdiction and this report is true to the best of my knowledge and belief. Weishaar Drilling 232 Business name _____ License No. _____ Address <u>Scott City, KS 67871</u> Signature _____ Date <u>12-4-76</u> Authorized representative <u>12-4-76</u>		
Topography: <input type="checkbox"/> Hill <input type="checkbox"/> Slope <input checked="" type="checkbox"/> Upland <input type="checkbox"/> Valley						

Forward the white, blue and pink copies to the Department of Health and Environment

Form WWC-5

T 18 R 33 NE 1/4 NE 1/4 NE 1/4