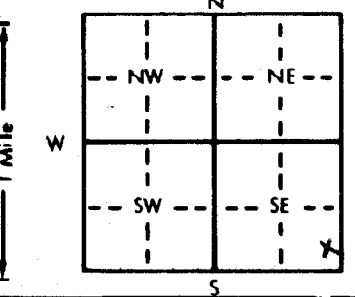


1 LOCATION OF WATER WELL: Fraction SE 1/4 SE 1/4 SE 1/4 Section Number 35 Township Number T 18 S Range Number R 33 **EW**  
 County: Scott

Distance and direction from nearest town or city street address of well if located within city?  
1 mile West 3 miles South of Scott City, Kansas

2 WATER WELL OWNER: Ted Crist  
 RR#, St. Address, Box #: R R Board of Agriculture, Division of Water Resources  
 City, State, ZIP Code: Scott City, Kansas 67871 Application Number:

3 LOCATE WELL'S LOCATION WITH AN "X" IN SECTION BOX:  
  
 4 DEPTH OF COMPLETED WELL: 140 ft. ELEVATION:  
 Depth(s) Groundwater Encountered 1. 81 ft. 2. ft. 3. ft.  
 WELL'S STATIC WATER LEVEL: 81 ft. below land surface measured on mo/day/yr 4/17/85  
 NA Pump test data: Well water was ft. after hours pumping gpm  
 Est. Yield gpm: Well water was ft. after hours pumping gpm  
 Bore Hole Diameter: 9 in. to 140 ft., and in. to ft.  
 WELL WATER TO BE USED AS:  
 1 Domestic  3 Feedlot  6 Oil field water supply  9 Dewatering  12 Other (Specify below)  
 2 Irrigation  4 Industrial  7 Lawn and garden only  10 Observation well  
 Was a chemical/bacteriological sample submitted to Department? Yes No  X; If yes, mo/day/yr sample was submitted  
 Water Well Disinfected? Yes  X No

5 TYPE OF BLANK CASING USED:  
 1 Steel  3 RMP (SR)  5 Wrought iron  8 Concrete tile CASING JOINTS:  Glued  Clamped  
 2 PVC  4 ABS  6 Asbestos-Cement  9 Other (specify below)  Welded  
 7 Fiberglass  Threaded  
 Blank casing diameter: 5 in. to 120 ft., Dia. in. to ft., Dia. in. to ft.  
 Casing height above land surface: 12 in., weight 2.9 lbs./ft. Wall thickness or gauge No. 265  
 TYPE OF SCREEN OR PERFORATION MATERIAL:  
 1 Steel  3 Stainless steel  5 Fiberglass  7 PVC  10 Asbestos-cement  
 2 Brass  4 Galvanized steel  6 Concrete tile  8 RMP (SR)  11 Other (specify)  
 12 None used (open hole)  
 SCREEN OR PERFORATION OPENINGS ARE:  
 1 Continuous slot  3 Mill slot  5 Gauzed wrapped  8 Saw cut  11 None (open hole)  
 2 Louvered shutter  4 Key punched  6 Wire wrapped  9 Drilled holes  
 7 Torch cut  10 Other (specify)  
 SCREEN-PERFORATED INTERVALS: From 120 ft. to 140 ft., From ft. to ft.  
 GRAVEL PACK INTERVALS: From 80 ft. to 140 ft., From ft. to ft.

6 GROUT MATERIAL:  1 Neat cement  2 Cement grout  3 Bentonite  4 Other Drill cuttings  
 Grout intervals: From 15 ft. to 80 ft., From 4 ft. to 15 ft., From ft. to ft.  
 What is the nearest source of possible contamination:  
 1 Septic tank  4 Lateral lines  7 Pit privy  10 Livestock pens  14 Abandoned water well  
 2 Sewer lines  5 Cess pool  8 Sewage lagoon  11 Fuel storage  15 Oil well/Gas well  
 3 Watertight sewer lines  6 Seepage pit  9 Feedyard  12 Fertilizer storage  16 Other (specify below)  
 13 Insecticide storage  
 Direction from well? East How many feet? 100

FROM	TO	LITHOLOGIC LOG	FROM	TO	LITHOLOGIC LOG
0	58	Clay	58	69	Fine sand clay streaks
69	80	Sand	80	88	Fine sand
88	98	Clay	98	107	Medium sand
107	120	Sand	120	129	Caliche
129	135	Sand	135	140	Yellow clay

7 CONTRACTOR'S OR LANDOWNER'S CERTIFICATION: This water well was  (1) constructed,  (2) reconstructed, or  (3) plugged under my jurisdiction and was completed on (mo/day/year) 4/22/85 and this record is true to the best of my knowledge and belief. Kansas Water Well Contractor's License No. 232 This Water Well Record was completed on (mo/day/yr) 4/24/85 under the business name of Weishaar Drilling & Supply Inc. by (signature) [Signature]

INSTRUCTIONS: Use typewriter or ball point pen, PLEASE PRESS FIRMLY and PRINT clearly. Please fill in blanks, underline or circle the correct answers. Send top three copies to Kansas Department of Health and Environment, Division of Environment, Environmental Geology Section, Topeka, KS 66620. Send one to WATER WELL OWNER and retain one for your records.