

CORRECTION(S) TO WATER WELL RECORD (WWC-5)
(to rectify lacking or incorrect information)

County: Scott

Location listed as:

Section-Township-Range: 18-22 S-33 W

Fraction (¼ ¼ ¼): SE SW SE

Location changed to:

4-18 S-33 W

SE SW SE

Other changes: Initial statements: _____

Changed to: _____

Comments: _____


verification method: Written description, position on plat map, other well information for same owner at same location, and mapping tool & aerial photo on KGS website initials: ORL date: 6/19/2012

submitted by: Kansas Geological Survey, Data Resources Library, 1930 Constant Ave., Lawrence, KS 66047-3726
to: Kansas Dept of Health & Environment, Bureau of Water, 1000 SW Jackson, Suite 420, Topeka, KS 66612-1367.

1 LOCATION OF WATER WELL: County: **Scott** Fraction: **SE 1/4 SW 1/4 SE 1/4** Section Number: **18** Township Number: **T 22 S** Range Number: **R 33 EW**

Distance and direction from nearest town or city street address of well if located within city?
Intersection Highway 83 & 96, Scott City, north 2 miles, west 3 1/4 miles

2 WATER WELL OWNER: **Robert V. Mulch**
 RR#, St. Address, Box # : **Route 3-164** Board of Agriculture, Division of Water Resources
 City, State, ZIP Code : **Scott City, KS 67871-9364** Application Number:

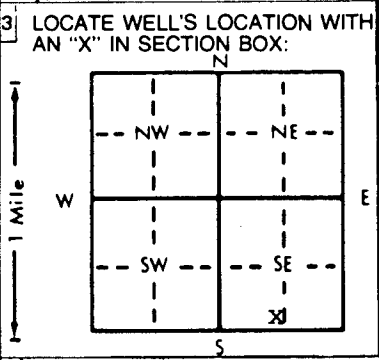

4 DEPTH OF COMPLETED WELL: **125** ft. ELEVATION: _____ ft.
 Depth(s) Groundwater Encountered 1. _____ ft. 2. _____ ft. 3. _____ ft.
 WELL'S STATIC WATER LEVEL: **121** ft. below land surface measured on **12/27/95**
 Pump test data: Well water was _____ ft. after _____ hours pumping _____ gpm
 Est. Yield _____ gpm: Well water was _____ ft. after _____ hours pumping _____ gpm
 Bore Hole Diameter _____ in. to _____ ft., and _____ in. to _____ ft.
 WELL WATER TO BE USED AS: 5 Public water supply 8 Air conditioning 11 Injection well
 (1 Domestic) 3 Feedlot 6 Oil field water supply 9 Dewatering 12 Other (Specify below)
 2 Irrigation 4 Industrial 7 Lawn and garden only 10 Monitoring well
 Was a chemical/bacteriological sample submitted to Department? Yes _____ No **X** If yes, mo/day/yr sample was submitted _____
 Water Well Disinfected? Yes **X** No

5 TYPE OF BLANK CASING USED: 5 Wrought iron 8 Concrete tile CASING JOINTS: Glued _____ Clamped _____
 (1 Steel) 3 RMP (SR) 6 Asbestos-Cement 9 Other (specify below) Welded _____
 2 PVC 4 ABS 7 Fiberglass _____ Threaded _____
 Blank casing diameter **six** in. to **125** ft., Dia _____ in. to _____ ft., Dia _____ in. to _____ ft.
 Casing height **below** land surface **36** in., weight _____ lbs./ft. Wall thickness or gauge No. _____
 TYPE OF SCREEN OR PERFORATION MATERIAL: 7 PVC 10 Asbestos-cement
 1 Steel 3 Stainless steel 5 Fiberglass 8 RMP (SR) 11 Other (specify) _____
 2 Brass 4 Galvanized steel 6 Concrete tile 9 ABS 12 None used (open hole)
 SCREEN OR PERFORATION OPENINGS ARE: 5 Gauzed wrapped 8 Saw cut 11 None (open hole)
 1 Continuous slot 3 Mill slot 6 Wire wrapped 9 Drilled holes
 2 Louvered shutter 4 Key punched 7 Torch cut 10 Other (specify) _____
 SCREEN-PERFORATED INTERVALS: From _____ ft. to _____ ft., From _____ ft. to _____ ft.
 From _____ ft. to _____ ft., From _____ ft. to _____ ft.
 GRAVEL PACK INTERVALS: From _____ ft. to _____ ft., From _____ ft. to _____ ft.
 From _____ ft. to _____ ft., From _____ ft. to _____ ft.

6 GROUT MATERIAL: 1 Neat cement 2 Cement grout (3 Bentonite) 4 Other _____
 Grout Intervals: From **0** ft. to **11** ft., From **57** ft. to **60** ft., From **113** ft. to **116** ft.
 What is the nearest source of possible contamination: 10 Livestock pens (14 Abandoned water well)
 1 Septic tank 4 Lateral lines 7 Pit privy 11 Fuel storage 15 Oil well/Gas well
 2 Sewer lines 5 Cess pool 8 Sewage lagoon 12 Fertilizer storage 16 Other (specify below)
 3 Watertight sewer lines 6 Seepage pit 9 Feedyard 13 Insecticide storage
 Direction from well? **West** How many feet? **Sixteen feet**

FROM	TO	LITHOLOGIC LOG	FROM	TO	PLUGGING INTERVALS
		Comments			
0	2	Used torch to cut out casing	0	11	grout
		Outside casing pack to top	11	57	sand
			57	60	grout
			60	113	sand
			113	116	grout
			116	125	sand

7 CONTRACTOR'S OR LANDOWNER'S CERTIFICATION: This water well was (~~3~~) **plugged** under my jurisdiction and was completed on (mo/day/year) **12/27/94** and this record is true to the best of my knowledge and belief. Kansas Water Well Contractor's License No. **NA** This Water Well Record was completed on (mo/day/yr) **1/31/95** under the business name of **Robert V. Mulch** by (signature) *Robert V. Mulch*