


South well

WATER WELL PLUGGING RECORD Form WWC-5P KSA 82a-1212 ID NO.

1 LOCATION OF WATER WELL: County: SCOTT Fraction SW 1/4 1/4 Section Number 55 Township Number T 10 S Range Number 34 E JW

Street/Rural Address of Well Location; if unknown, distance & direction from nearest town or intersection: If at owner's address, check here [] Global Positioning Systems (GPS) information: Latitude: (in decimal degrees) Longitude: (in decimal degrees) Elevation: Datum: [] WGS84, [] NAD83, [] NAD27 Collection Method: [] GPS unit (Make/Model): [] Digital Map/Photo, [] Topographic Map, [] Land Survey Est. Accuracy: [] <3 m, [] 3-5 m, [] 5-15 m, [] >15 m

2 WATER WELL OWNER: Jeff + Barbara W. Kinison RR#, St. Address, Box #: 706 Ora St. City, State ZIP Code: Scott City, KS 67871

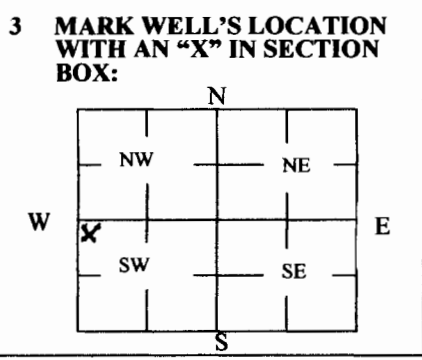

4 DEPTH OF WELL 190 ft. WELL'S STATIC WATER LEVEL 25 ft. WELL WAS USED AS: [] Domestic [] Public Water Supply [] Dewatering [x] Irrigation [] Oil Field Water Supply [] Monitoring [] Feedlot [] Domestic (Lawn & Garden) [] Injection Well [] Industrial [] Air Conditioning [] Other Was a chemical/bacteriological sample submitted to Department? Yes [] No [x]

5 TYPE OF BLANK CASING USED: [x] Steel [] PVC [] RMP (SR) [] ABS [] Wrought Asbestos-Cement [] Fiberglass [] Concrete Tile [] Other (Specify below) Blank casing diameter 16 in. Was casing pulled? Yes [x] No [] If yes, how much 62" Casing height above or below land surface 52 in.

6 GROUT PLUG MATERIAL: [] Neat cement [] Cement grout [x] Bentonite [] Other Grout Plug Intervals: From 190 ft. to 7 ft., From 7 ft. to 4 ft., From 4 ft. to 0 ft. What is the nearest source of possible contamination: [x] Septic tank [] Sewer lines [] Watertight sewer lines [] Lateral lines [] Cess pool [] Seepage pit [] Pit privy [] Sewage lagoon [] Feedyard [] Livestock pens [] Fuel storage [] Fertilizer storage [] Insecticide storage [] Abandoned water well [] Oil well/Gas well [] Other (specify below) Direction from well? S How many feet? 2640

Table with 6 columns: FROM, TO, PLUGGING MATERIALS, FROM, TO, PLUGGING MATERIALS. Rows: 190 to 7 (Sand), 7 to 4 (Bentonite), 4 to 0 (Dirt).

7 CONTRACTOR'S OR LANDOWNER'S CERTIFICATION: This water well was plugged under my jurisdiction and was completed on (mo/day/year) 7-16-2015 and this record is true to the best of my knowledge and belief. Kansas Water Well Contractor's License No. This Water Well Record was completed on (mo/day/year) 7-17-2015 under the business name of Jones Construction by (signature) Jeff Kinison

INSTRUCTIONS: Use typewriter or ballpoint pen. Please press firmly and print clearly. Please fill in blanks, underline or circle the correct answers. Send top three copies to Kansas Department of Health and Environment, Bureau of Water, Geology Section, 1000 SW Jackson St., Ste. 420, Topeka, Kansas 66612-1367. Telephone: 785/296-5524. Send one to Water Well Owner and retain one for your records. Visit us at http://www.kdheks.gov/waterwell/index.html.