


1 LOCATION OF WATER WELL: Fraction NW 1/4 SW 1/4 SE 1/4 Section Number 14 Township Number T 18 S Range Number R 34 EW

County: Scott Distance and direction from nearest town or city street address of well if located within city? 7 1/2 miles West 1/4 mile North of Scott City, Kansas

2 WATER WELL OWNER: H R C Feed Yards RR#, St. Address, Box #: Box 186 City, State, ZIP Code: Scott City, Kansas 67871 Board of Agriculture, Division of Water Resources Application Number: 36649

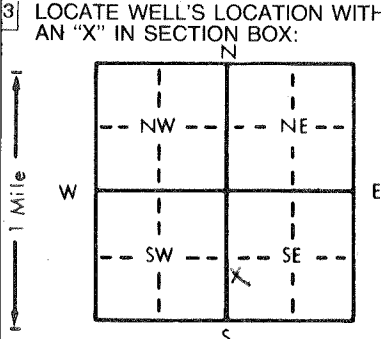

3 LOCATE WELL'S LOCATION WITH AN "X" IN SECTION BOX: [Diagram]

4 DEPTH OF COMPLETED WELL: 150 ft. ELEVATION: ... ft.

Depth(s) Groundwater Encountered 1...121...ft. 2...ft. 3...ft.

WELL'S STATIC WATER LEVEL .121...ft. below land surface measured on mo/day/yr 7-7-83

Pump test data: Well water was .126...ft. after .4...hours pumping .20...gpm

Est. Yield .30...gpm: Well water was .130...ft. after .4...hours pumping .30...gpm

Bore Hole Diameter .9...in. to .150...ft., and...in. to...ft.

WELL WATER TO BE USED AS: 5 Public water supply 8 Air conditioning 11 Injection well
 1 Domestic 3 Feedlot 6 Oil field water supply 9 Dewatering 12 Other (Specify below)
 2 Irrigation 4 Industrial 7 Lawn and garden only 10 Observation well

Was a chemical/bacteriological sample submitted to Department? Yes...No...X...; If yes, mo/day/yr sample was submitted

Water Well Disinfected? Yes X No

5 TYPE OF BLANK CASING USED: 1 Steel 2 PVC 3 RMP (SR) 4 ABS 5 Wrought iron 6 Asbestos-Cement 7 Fiberglass 8 Concrete tile 9 Other (specify below) CASING JOINTS: 8 Glued 9 Clamped 10 Welded 11 Threaded

Blank casing diameter .5...in. to .120...ft., Dia...in. to...ft., Dia...in. to...ft.

Casing height above land surface .12...in., weight .2.9...lbs./ft. Wall thickness or gauge No. 265

TYPE OF SCREEN OR PERFORATION MATERIAL: 1 Steel 2 Brass 3 Stainless steel 4 Galvanized steel 5 Fiberglass 6 Concrete tile 7 PVC 8 RMP (SR) 9 ABS 10 Asbestos-cement 11 Other (specify) 12 None used (open hole)

SCREEN OR PERFORATION OPENINGS ARE: 1 Continuous slot 2 Louvered shutter 3 Mill slot 4 Key punched 5 Gauzed wrapped 6 Wire wrapped 7 Torch cut 8 Saw cut 9 Drilled holes 10 Other (specify) 11 None (open hole)

SCREEN-PERFORATED INTERVALS: From .120...ft. to .150...ft., From...ft. to...ft.

GRAVEL PACK INTERVALS: From .100...ft. to .150...ft., From...ft. to...ft.

6 GROUT MATERIAL: 1 Neat cement 2 Cement grout 3 Bentonite 4 Other Drill cuttings

Grout Intervals: From .15...ft. to .100...ft., From .4...ft. to .15...ft., From...ft. to...ft.

What is the nearest source of possible contamination: 1 Septic tank 2 Sewer lines 3 Watertight sewer lines 4 Lateral lines 5 Cess pool 6 Seepage pit 7 Pit privy 8 Sewage lagoon 9 Feedyard 10 Livestock pens 11 Fuel storage 12 Fertilizer storage 13 Insecticide storage 14 Abandoned water well 15 Oil well/Gas well 16 Other (specify below)

Direction from well? East How many feet? 2600

FROM	TO	LITHOLOGIC LOG	FROM	TO	LITHOLOGIC LOG
0	25	Clay	25	37	Gyp
37	44	Clay	44	53	Sand rock
53	57	Clay	57	67	Fine sand
67	100	Sand	100	102	Sand cemented
102	108	Fine sand clay streaks	108	111	Sand cemented
111	128	Fine sand clay streaks	128	131	Medium sand
131	141	Fine sand clay streaks	141	150	Yellow clay

7 CONTRACTOR'S OR LANDOWNER'S CERTIFICATION: This water well was (1) constructed (2) reconstructed, or (3) plugged under my jurisdiction and was completed on (mo/day/year) 7/7/83 and this record is true to the best of my knowledge and belief. Kansas Water Well Contractor's License No. 232 This Water Well Record was completed on (mo/day/yr) 7/11/83 under the business name of Weishaar Drilling & Supply Inc. by (signature) [Signature]

INSTRUCTIONS: Use typewriter or ball point pen, PLEASE PRESS FIRMLY and PRINT clearly. Please fill in blanks, underline or circle the correct answers. Send top three copies to Kansas Department of Health and Environment, Division of Environment, Environmental Geology Section, Topeka, KS 66620. Send one to WATER WELL OWNER and retain one for your records.